

Madison
T 36
5-7-70

MISSISSIPPI
 BOARD OF WATER COMMISSIONERS
 416 North State Street
 Jackson, Mississippi 39201

CODED

WATER WELL DRILLERS LOG


May 7 1970 John Davis Madison
 date well completed firm name county well located

| LANDOWNER: | description of formations encountered | from | to |
|---|---------------------------------------|------------|------------|
| <u>Lee Earnie Tiler</u> | <u>Red Clay</u> | <u>0</u> | <u>40</u> |
| | <u>White Clay</u> | <u>40</u> | <u>60</u> |
| | <u>Blue Clay</u> | <u>60</u> | <u>240</u> |
| (mailing address) | <u>Blue Clay & Sand Beds</u> | <u>240</u> | <u>470</u> |
| | <u>Good Sand</u> | <u>470</u> | <u>530</u> |
| WELL LOCATION: | | | |
| sec. <u>20</u> T. <u>8N</u> R. <u>2E</u> <u>044</u> | | | |
| <u>5</u> miles <u>W.</u> of <u>Glucostant</u> | | | |
| (distance) (direction) (nearest town) | | | |
| WELL PURPOSE: | | | |
| (home, irrigation, municipal, industrial) | | | |
| WELL COMPLETION DATA: | | | |
| (1) diameter (inches) <u>2"</u> | | | |
| (2) total depth (feet) <u>530</u> | | | |
| (3) static water level (feet) <u>70</u> <u>below</u> above top of ground. | | | |
| (4) casing <u>Galv</u> <u>520</u> | | | |
| (material) (depth) | | | |
| <u>2"</u> if telescope see back. | | | |
| (size) | | | |
| (5) screen <u>10'</u> <u>520'</u> | | | |
| (length) (depth to top) | | | |
| <u>.007 2"</u> <u>SS</u> | | | |
| (size) (material) | | | |
| (6) pump <u>2</u> <u>14</u> | | | |
| (HP) (yield gpm) | | | |
| (type power) <u>Air</u> | | | |
| (7) electric log <u>NO</u> | | | |
| (yes or no) | | | |
| (organization running log) | | | |
| (8) how well bottom plugged <u>Drop</u> | | | |
| <u>PIN</u> | | | |
| DRILLERS REMARKS: | | | |

JUN 3 1970
 MISS. BD OF
 WATER COM.

If well telescopes please sketch and show depths.

GROUND LEVEL

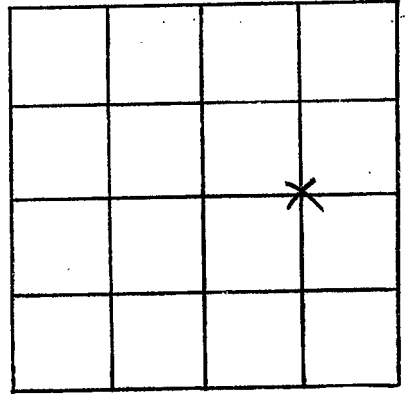

SECTION 20

Please indicate well location X.

ADDITIONAL INFORMATION

If more than one screen, show locations of each on sketch.