

MADISON

T 37

12-8-70

MISSISSIPPI BOARD OF WATER COMMISSIONERS
416 North State Street
Jackson, Mississippi 39201

CODED

WATER WELL DRILLERS LOG

Dec 8 1970 John Davis Madison
date well completed firm name county well located

LANDOWNER: Wiley
Madison Miss
(mailing address)

description of formations encountered	from	to
Red Clay	0	59
Blue Clay	59	173
Moodie's Brack with it rocks	173	215
Blue clay	216	276
Sand Brakes	276	336
Blue Clay	336	376
Sand Brakes	376	416
Mud Sand	416	436

WELL LOCATION:
sec 36 T 8 N R 2 E
3 miles NE of Madison
(distance) (direction) (nearest town)

WELL PURPOSE:
(home, irrigation, municipal, industrial)

- WELL COMPLETION DATA:
- (1) diameter (inches) 2
 - (2) total depth (feet) 436
 - (3) static water level (feet) 70 below top of ground.
 - (4) casing Gal (material) 436 (depth)
 - (5) screen 10 (length) 436 (depth to top)
2" (size) 33 (material)
 - (6) pump 2 (HP) 70 (yield gpm)
Electric (type power)
 - (7) electric log (yes or no) no
 - (8) how well bottom plugged plug

CODED


DEC 10 1970

MISS. Bd. OF WATER COMMISSIONERS

DRILLERS REMARKS:

If well telescopes please sketch and show depths.

GROUND LEVEL

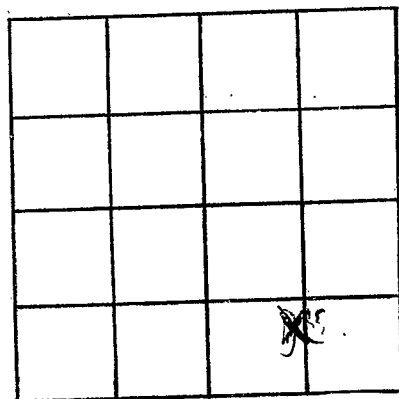

SECTION _____

Please indicate well location X.

ADDITIONAL INFORMATION

If more than one screen,
show locations of each on sketch.