

SE SE
Madison
T 33 40
11-7-69

MISSISSIPPI
 BOARD OF WATER COMMISSIONERS
 416 North State Street
 Jackson, Mississippi 39201

CODED

WATER WELL DRILLERS LOG

11/7 1969 JOHN A. DAVIS MADISON
 date well completed firm name county well located

LANDOWNER: D.W. Wagner
Acme Printing Co.
Jackson, Miss.
 (mailing address)

description of formations encountered	from	to
Clay, red	0	60
Clay, blue	60	189
Sand & (MB)	189	289
Shell	289	309
Shell	309	329
Fine Sand	329	349
Fine Sand	349	369
Shell	369	389
Shell & Rock	389	409
Sand, good	409	489

WELL LOCATION:
 sec. 36 8 N R 2 E
8 miles S of Canton
 (distance) (direction) (nearest town)

WELL PURPOSE:
 (home, irrigation, municipal, industrial)

WELL COMPLETION DATA:

(1) diameter (inches) 2"
 (2) total depth (feet) 489
 (3) static water level (feet) 60 below top of ground.
 (4) casing 2" 469
 (material) (depth)
 (size) if telescope see back.
 (5) screen 20 469
 (length) (depth to top)
2" #7 SS
 (size) (material)
 (6) pump 2 25
 (HP) (yield gpm)
Air.
 (type power)
 (7) electric log No
 (yes or no)
 (organization running log)
 (8) how well bottom-plugged Pin

NOV 10 1969


DRILLERS REMARKS:

Iron

MISS. BD. OF
 WATER COMMISSIONERS

If well telescopes please sketch and show depths.

GROUND LEVEL

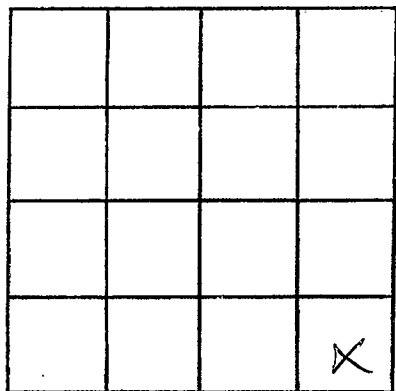

SECTION 36

Please indicate well location X.

ADDITIONAL INFORMATION

If more than one screen,
show locations of each on sketch.