

Madison
T 244
1-2-70

MISSISSIPPI
BOARD OF WATER COMMISSIONERS
416 North State Street
Jackson, Mississippi 39201

Rev 11/9/70
Rev 1/13/70

CODED
CODED


WATER WELL DRILLERS LOG

Jan 2 1970 JOHN A. DAVIS MADISON
date well completed firm name county well located

LANDOWNER:	description of formations encountered	from	to
Arthur Jackson	Red Clay	0	18
Gluckstadt	White Clay	18	39
(mailing address)	Blue Clay	39	228
WELL LOCATION: NW of SE	Muddy Branch	228	249
sec. 25 T 8 N R 2 E	Muddy Branch	249	264
3 miles W of Gluckstadt	Blue Clay	264	270
(distance) (direction) (nearest town)	Sand breaks	270	291
WELL PURPOSE:	Rocks & Sand streaks	291	311
(home, irrigation, municipal, industrial)	Blue Clay	311	331
WELL COMPLETION DATA:	Fine sand & clay	331	357
(1) diameter (inches) 2	Sand breaks	357	391
(2) total depth (feet) 431	Blue Clay	391	411
(3) static water level (feet) 70 below top of ground	Dark Sand	411	431
(4) casing Dalor 421 (material) (depth)			
2" (size) if telescope see back.			
(5) screen 10 421 (length) (depth to top)			
2" (size) SS (material)			
(6) pump 2 20 (HP) (yield gpm)			
elec (type power)			
(7) electric log No (yes or no)			
(organization running log)			
(8) how well bottom plugged Pin			
DRILLERS REMARKS:			
Good well!			

If well telescopes please sketch and show depths.

GROUND LEVEL

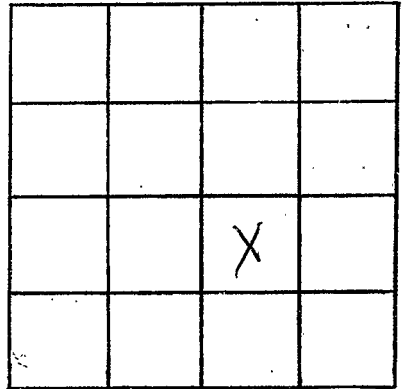

SECTION 25

Please indicate well location X.

ADDITIONAL INFORMATION

A series of horizontal lines for writing additional information, starting below the 'ADDITIONAL INFORMATION' header and extending to the bottom of the page.

If more than one screen, show locations of each on sketch.