

MADISON

MISSISSIPPI BOARD OF WATER COMMISSIONERS

WATER WELL DRILLERS LOG

CODED

OT 42

6-5-61

Date: 6/5, 1961, Driller: McKoy County Madison

(Name)

BRISTAR

(1) Owner of Land: Bally Bristea (Name) Canton Miss (Address)

Description & Color of Materials Sand, Clay, Red Clay, Shell, etc.

Thickness Feet

Depth Feet

W hto. Clay Blue Clay

0 21

21 42

42 63

63 84

84 105

105 126

126 147

147 168

168 189

189 210

210 231

231 252

252 273

273 294

294 315

315 336

336 357

357 378

378 399

399 420

420 441

441 462

462 484

(2) Location: 1/4, 1/4, Sec. 24 T. 8 R. 2E, 8 miles S E of Canton (distance) (direction) (Nearest Town)

(3) Topography: (Hilly) (Flat) (Level)

(4) Purpose of Well: Home (Domestic Irrigation Municipal, Industrial, Other)

Information upon completion of well:

(1) Diameter 3 inches.

(2) Total Depth 484 feet.

(3) Water level 68 feet below top of ground.

(4) Cased to, Size

(5) Screen: Size 006, Length 20

(6) Were any formations sealed against pollution?

yes, no.


If YES depth of formation

Why

Drillers Remarks:

3HP AIR Unit

2.5 gal min

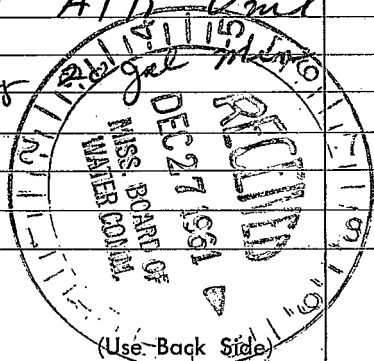

Well No.

100

101

102

200