

T 43

1-11-63

WATER WELL DRILLERS LOG

CODED

Date: Jan 11, 1963, Driller: M<sup>r</sup> Kary County: Madison

(1) Owner of Land: R. MAYFIELD  
 (Name)  
 Canton Miss  
 (Address)  
 23  
 29 TO R 2E

(2) Location: 1/4, 1/4, Sec. 23 TO R 2E  
 7 miles S, of Canton  
 (distance) (direction) (Nearest Town)

(3) Topography:  (Hilly)  (Flat)  (Level)

(4) Purpose of Well: HOME  
 (Domestic Irrigation  
 Municipal, Industrial, Other)

Description & Color of Materials Sand, Clay, Red Clay, Shell, etc.	Thick- ness Feet	Depth Feet
White Clay	0	21
Blue Clay	21	42
Blue clay	43	189
Rock	189	191
Meddy Branch Sand	191	231
Blue clay	231	252
Clay - Sand 5 1/4"	253	315
2-8 " "	315	357
Fine Sand	357	504
Med Sand -	504	567

Information upon completion of well:

(1) Diameter 2 inches.

(2) Total Depth 567 feet.

(3) Water Level 65 feet below top of ground.

(4) Cased to \_\_\_\_\_, Size \_\_\_\_\_.

(5) Screen: Size 006, Length 30ft.

(6) Were any formations sealed against pollution?  
 \_\_\_\_\_ yes,  no.

If YES depth of formation \_\_\_\_\_

Why \_\_\_\_\_


Drillers Remarks: \_\_\_\_\_

\_\_\_\_\_

\_\_\_\_\_

AIR UNIT

CODED

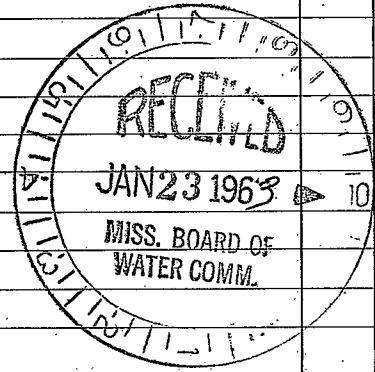

(Use Back Side)

Well No.

