

T44

2-17-64

WATER WELL DRILLERS LOG

CODED

Date: 2/17, 1964, Driller: ~~Madison~~ McKay County Madison

(Name)

HARVEY

(1) Owner of Land: Watts

(Name)

Madison Miss 32 0 2E

(Address)

(2) Location: 1/4, 1/4, Sec. 5 T 7 R 2E

3 miles NW of Madison

(distance)

(direction)

(Nearest Town)

(3) Topography: [check]

(Hilly)

(Flat)

(Level)

(4) Purpose of Well: Home

(Domestic Irrigation, Municipal, Industrial, Other)

Description & Color of Materials Sand, Clay, Red Clay, Shell, etc.

Thick-ness Feet

Depth Feet

Yellow Clay	0	20
Blue clay	2.0	42
Blue clay	42	294
Moody Brackish sand	294	315
" "	315	336
Brown Clay	336	357
" " " " " " " "	357	378
" " " " " " " "	378	420
Fine sand	420	483
Med Sand	483	520

Information upon completion of well:

(1) Diameter 2 inches.

(2) Total Depth 525 feet.

(3) Water Level 104 feet below top of ground.

(4) Cased to \_\_\_\_\_, Size \_\_\_\_\_

(5) Screen: Size 007, Length 20

(6) Were any formations sealed against pollution?


yes, [check] no.

If YES depth of formation \_\_\_\_\_

Why \_\_\_\_\_

Drillers Remarks: \_\_\_\_\_

CODED

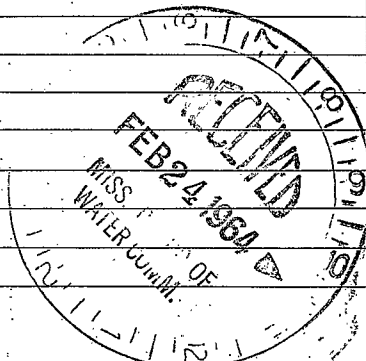

(Use Back Side)

Well No.

