

MT 45

WATER WELL DRILLERS LOG

CODED

2-24-64

Date: 2/24, 19

Driller:

MCKAY
(Name)

County MADISON

(1) Owner of Land: TOMMIE HARRIS
(Name)

CANTON MISS
(Address)

(2) Location: 1/4, 1/4, Sec. 3 T8 R2E

5 miles SW of Canton
(distance) (direction) (Nearest Town)

(3) Topography: (Hilly) (Flat) (Level)

(4) Purpose of Well: _____
(Domestic Irrigation, Municipal, Industrial, Other)

Description & Color of Materials Sand, Clay, Red Clay, Shell, etc.	Thick- ness Feet	Depth Feet
<u>White Clay</u>	<u>0</u>	<u>21</u>
<u>Blue Clay</u>	<u>21</u>	<u>42</u>
<u>Blue Clay</u>	<u>42</u>	<u>63</u>
<u>Blue Clay</u>	<u>63</u>	<u>231</u>
<u>Med. Sand</u>	<u>231</u>	<u>252</u>
<u>3 in Sand & clay</u>	<u>252</u>	<u>373</u>
<u>3 in Sand</u>	<u>273</u>	<u>315</u>
<u>Med Sand</u>	<u>315</u>	<u>357</u>

3HP AIR UNIT

Information upon completion of well:

(1) Diameter 2 inches.

(2) Total Depth 357 feet.

(3) Water Level 83 feet below top of ground.

(4) Cased to _____, Size _____

(5) Screen: Size 007, Length 20


(6) Were any formations sealed against pollution?
_____ yes, no.

If YES, depth of formation _____

Why _____

Drillers Remarks: _____

CODED

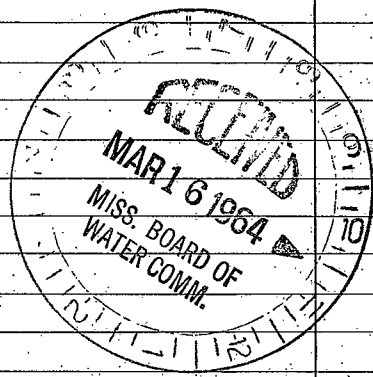

(Use Back Side)

Well No.

