

T 46

3-3-64

WATER WELL DRILLERS LOG

**CODED**

Date: 3/3, 1964, Driller: MCKAY County MADISON  
(Name)

(1) Owner of Land: WILLIE ALLEN  
(Name)  
Canton Miss  
(Address)

(2) Location: 1/4, 1/4, Sec. 15 T8 R25  
7 miles S of Canton  
(distance) (direction) (Nearest Town)

(3) Topography: —  
(Hilly) (Flat) (Level)

(4) Purpose of Well: Home  
(Domestic Irrigation, Municipal, Industrial, Other)

Description & Color of Materials Sand, Clay, Red Clay, Shell, etc.	Thick- ness Feet	Depth Feet
<u>White Clay</u>	<u>0</u>	<u>21</u>
<u>White Clay</u>	<u>21</u>	<u>42</u>
<u>Blue Clay</u>	<u>43</u>	<u>63</u>
<u>Blue Clay</u>	<u>63</u>	<u>168</u>
<u>Brown Clay</u>	<u>168</u>	<u>210</u>
<u>Fine Sandy Clay</u>	<u>210</u>	<u>252</u>
<u>Mucky Brown Sand</u>	<u>252</u>	<u>273</u>
<u>...</u>	<u>273</u>	<u>284</u>
<u>Fine Sandy - Clay</u>	<u>284</u>	<u>315</u>
<u>...</u>	<u>315</u>	<u>336</u>
<u>Sand - 5" Tan Clay</u>	<u>336</u>	<u>357</u>
<u>...</u>	<u>357</u>	<u>441</u>
<u>Med Sand -</u>	<u>441</u>	<u>483</u>

Information upon completion of well:

(1) Diameter 2 inches.

(2) Total Depth 483 feet.

(3) Water Level 64 feet below top of ground.


(4) Cased to \_\_\_\_\_, Size \_\_\_\_\_

(5) Screen: Size 007, Length 10

(6) Were any formations sealed against pollution?  
 \_\_\_\_\_ yes,  no.

1/2 H.P. jet  
105 ft 1/4 jet pipe

**CODED**

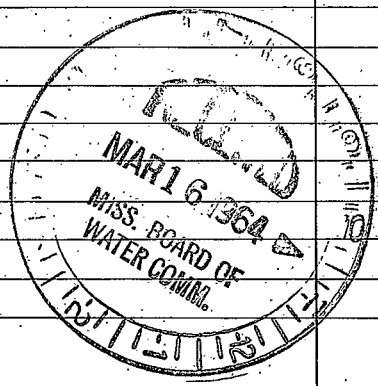

(Use Back Side)

Well No.

