

MADISON

T47

6-15-64

WATER WELL DRILLING

Date: 6/15, 1964, Driller: M. Kay (Name) CODED County Madison

BILL SCHMIDT

(1) Owner of Land: W.M. Schmidt (Name)

Madison, Miss (Address)

(2) Location: 1/4, 1/4, Sec. 29 T8 R2E

6 miles NW of Madison (distance, direction, Nearest Town)

(3) Topography: [check] (Hilly, Flat, Level)

(4) Purpose of Well: FARM (Domestic Irrigation, Municipal, Industrial, Other)

Information upon completion of well:

(1) Diameter 2 inches.

(2) Total Depth 560 feet.

(3) Water Level 144 feet below top of ground.

(4) Cased to \_\_\_\_\_, Size \_\_\_\_\_

(5) Screen: Size 007, Length 20

(6) Were any formations sealed against pollution?

yes, [check] no.


If YES depth of formation \_\_\_\_\_

Why \_\_\_\_\_

Drillers Remarks: \_\_\_\_\_

Description & Color of Materials Sand, Clay, Red Clay, Shell, etc.	Thick- ness Feet	Depth Feet
White clay	0	30
" "	30	40
Blue clay	40	60
" "	60	100
Blue clay	100	140
Blue clay	140	340
Sea shell sand	340	380
Segment sand	380	400
Rock - shale	400	415
sandy clay	415	420
" "	420	460
" "	460	500
Sand	500	520
Sand	520	540
Sand	540	560

CODED

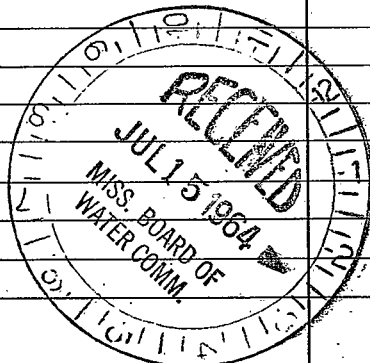

(Use Back Side)

Well No.

