

T48

8-17-64

WATER WELL DRILLERS LOG

**CODED**

Date: 8/17, 1964, Driller: M Kay County Madison  
(Name)

- (1) Owner of Land: Ralph Sewell  
(Name)  
Madison Miss  
(Address)
- (2) Location: 1/4, 1/4, Sec. 15 T. 8 R. 2E,  
6 miles S, of Centon  
(distance) (direction) (Nearest Town)
- (3) Topography:  (Hilly)  (Flat)  (Level)
- (4) Purpose of Well: Home  
(Domestic Irrigation Municipal, Industrial, Other)

Description & Color of Materials Sand, Clay, Red Clay, Shell, etc.	Thick- ness Feet	Depth Feet
<u>Clay</u>	<u>0</u>	<u>20</u>
<u>Clay</u>	<u>20</u>	<u>40</u>
<u>Blue Clay</u>	<u>40</u>	<u>160</u>
<u>Mucky Brown</u>	<u>160</u>	<u>200</u>
<u>Sandy Clay</u>	<u>200</u>	<u>220</u>
<u>Fine Sandy Clay</u>	<u>220</u>	<u>380</u>
<u>.....</u>	<u>380</u>	<u>400</u>
<u>Fine Sand</u>	<u>400</u>	<u>420</u>
<u>Med. Sand</u>	<u>420</u>	<u>460</u>

Information upon completion of well:


- (1) Diameter 2 inches.
- (2) Total Depth 460 feet.
- (3) Water Level 88 feet below top of ground.
- (4) Cased to \_\_\_\_\_, Size \_\_\_\_\_.
- (5) Screen: Size 007, Length 20.
- (6) Were any formations sealed against pollution?  
 \_\_\_\_\_ yes,  no.

3HP pumps

**CODED**

If YES depth of formation \_\_\_\_\_  
 Why \_\_\_\_\_

Drillers Remarks: \_\_\_\_\_  
 \_\_\_\_\_  
 \_\_\_\_\_

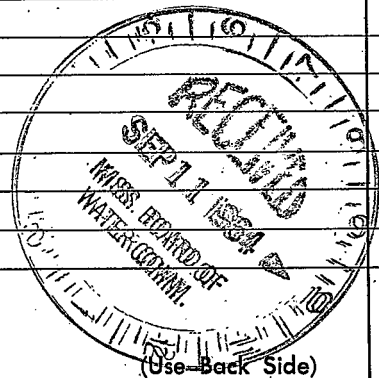

Well No.

1912

1912

1912

The following is a list of the names of the persons who have been  
 named in the various reports of the Board of Directors of the  
 company during the year ending December 31, 1912. The names  
 are given in alphabetical order of the surnames.

1912

The following is a list of the names of the persons who have been  
 named in the various reports of the Board of Directors of the  
 company during the year ending December 31, 1912. The names  
 are given in alphabetical order of the surnames.