

NT 49

2-16-65

WATER WELL DRILLERS LOG

CODED

Date: Feb 16, 1965, Driller: MCKAY County: MADISON

(1) Owner of Land: S. J. Whaley
 (Name)
Canton Miss
 (Address)

(2) Location: 1/4, 1/4, Sec. 13 T8 R25
5 miles S.E. of Canton
 (distance) (direction) (Nearest Town)

(3) Topography: (Hilly) (Flat) (Level)

(4) Purpose of Well: Home
 (Domestic Irrigation
 Municipal, Industrial, Other)

Description & Color of Materials Sand, Clay, Red Clay, Shell, etc.	Thick- ness Feet	Depth Feet
<u>Clay</u>	<u>0</u>	<u>20</u>
<u>Blue clay</u>	<u>20</u>	<u>40</u>
<u>Blue clay</u>	<u>40</u>	<u>140</u>
<u>Snake Shale</u>	<u>140</u>	<u>260</u>
<u>Fine Sand</u>	<u>260</u>	<u>300</u>
<u>Med Sand</u>	<u>300</u>	<u>360</u>
<u>Blue clay</u>	<u>360</u>	<u>365</u>

Information upon completion of well:

(1) Diameter 2 inches.

(2) Total Depth 360 feet.

(3) Water Level 81 feet below top of ground.

(4) Cased to _____, Size _____.

(5) Screen: Size 007, Length 20.


(6) Were any formations sealed against pollution?
 _____ yes, no.

If YES depth of formation _____

Why _____

Drillers Remarks: _____

CODED

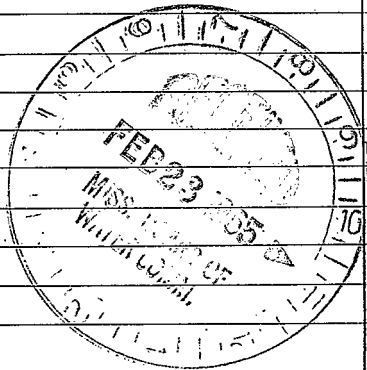

(Use Back Side)

Well No.

