

MADISON

WATER WELL DRILLING

G

CODED

T 50

Date: Aug 16, 1965, Driller: MCKAY

County: MADISON

8-16-65 R.W.

(Name)

(1) Owner of Land: BOB HOBBS

(Name)

Madison Miss

(Address)

(2) Location: 1/4, 1/4, Sec. 19 T 8 R 2E

8 miles SW of Canton

(distance)

(direction)

(Nearest Town)

(3) Topography: [check] (Hilly) (Flat) (Level)

(4) Purpose of Well: Home (Domestic Irrigation, Municipal, Industrial, Other)

Information upon completion of well:

(1) Diameter 2 inches.

(2) Total Depth 1400 feet.

(3) Water Level 173 feet below top of ground.

(4) Cased to _____, Size _____

(5) Screen: Size 0.07, Length 20

(6) Were any formations sealed against pollution?

yes, [check] no.

If YES depth of formation _____

Why _____


Drillers Remarks: _____

Description & Color of Materials Sand, Clay, Red Clay, Shell, etc.	Thick- ness Feet	Depth Feet
White Clay	0	20
Blue Clay	20	41
Blue Clay	40	60
Shells and Sand	40	280
Shale	280	300
Sand-Shale	300	500
Gravel	500	600
Fine Sand	600	700
Clay	700	740
Sandy Shale	740	760
Gravel	760	840
Sandy Shale	840	980
Shale	980	1020
Med Sand	1020	1060
	1060	1000

CODED

Air Pump

3HP - 230v

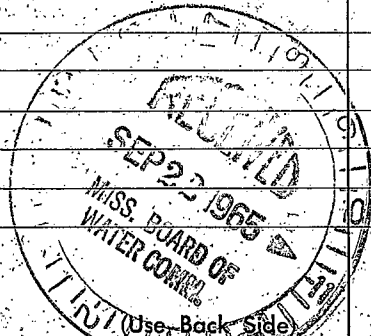

Well No.

(Use Back Side)

...LERS LO

... ..
... ..
... ..