

MADISON MISSISSIPPI BOARD OF WATER COMMISSIONERS

W T 51
12-3-65

WATER WELL DRILLERS LOG

CODED

Date: Dec 3, 1965, Driller: M^{rs} KAY County MADISON
(Name)

(1) Owner of Land Jerry Lee Dawgint
(Name)
Madison Miss
(Address)

(2) Location: 1/4, 1/4, Sec. 25 T8 R2E
6 miles E of Madison
(distance) (direction) (Nearest Town)

(3) Topography: (Hilly) (Flat) (Level)

(4) Purpose of Well: (Domestic Irrigation)
 (Municipal, Industrial, Other)

Description & Color of Materials Sand, Clay, Red Clay, Shell, etc.	Thick- ness Feet	Depth Feet
<u>White Clay</u>	<u>0</u>	<u>20</u>
<u>White Clay</u>	<u>20</u>	<u>40</u>
<u>Blue Clay</u>	<u>40</u>	<u>60</u>
<u>Blue Clay</u>	<u>60</u>	<u>220</u>
<u>Washed Brown</u>	<u>220</u>	<u>240</u>
<u>Blue Clay</u>	<u>240</u>	<u>460</u>
<u>Sand</u>	<u>460</u>	<u>500</u>

Information upon completion of well:

(1) Diameter 2 inches.

(2) Total Depth 500 feet.

(3) Water Level 74 feet below top of ground.

(4) Cased to _____, Size _____

(5) Screen: Size 007, Length 20

(6) Were any formations sealed against pollution?
no yes, no.


CODED

Jet Pump

If YES depth of formation _____

Why _____

Drillers Remarks: _____

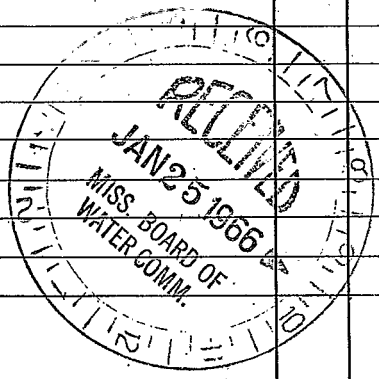

(Use Back Side)

Well No.

