

MADISON MISSISSIPPI BOARD OF WATER COMMISSIONERS

WT 53

5-12-66

WATER WELL DRILLERS LOG

CODED

Date: 5-12, 1966, Driller: J P Thornton County Madison
 (Name)

(1) Owner of Land: J C Smith
 (Name)
Canton miss
 (Address)

(2) Location: 1/4, 1/4, Sec. 4 T8 R2E
3 miles SW, of Canton
 (distance) (direction) (Nearest Town)

(3) Topography: (Hilly) (Flat) (Level)

(4) Purpose of Well: Domestic
 (Domestic Irrigation
 Municipal, Industrial, Other)

Description & Color of Materials Sand, Clay, Red Clay, Shell, etc.	Thick- ness Feet	Depth Feet
<u>red clay</u>	<u>30</u>	<u>bt</u>
<u>green chalk</u>	<u>70</u>	
<u>Black dirt</u>	<u>150</u>	
<u>Black sand</u>	<u>90</u>	
<u>gray shale</u>	<u>75</u>	
<u>fine gray sand</u>	<u>70</u>	
<u>chalk + sand</u>	<u>15</u>	
<u>white water sand</u>	<u>47</u>	
	<u>547</u>	

Information upon completion of well:

(1) Diameter 2 inches.

(2) Total Depth 547 feet.

(3) Water Level 212 feet below top of ground.

(4) Cased to 504, Size 2


(5) Screen: Size 1/4, Length 12 ft

(6) Were any formations sealed against pollution?
no, yes, no.

If YES depth of formation _____
 Why _____

Drillers Remarks: 600 gal per hr

CODED

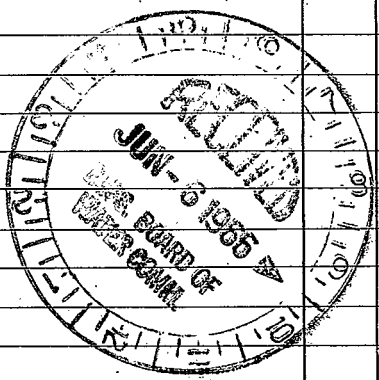

(Use Back Side)

Well No.

[The page contains extremely faint and illegible text, likely bleed-through from the reverse side of the document. No specific words or phrases can be transcribed.]