

MADISON
T 54
7-30-68

MISSISSIPPI **E LOG #187**
 BOARD OF WATER COMMISSIONERS
 416 North State Street
 Jackson, Mississippi 39201

WATER WELL DRILLERS LOG **CODED**

11/20/68 19 B. C. Thompson Madison
 date well completed firm name county well located

LANDOWNER: Rose Chapel
Blanchard Miss.

description of formations encountered	from	to
<u>clay</u>	<u>0</u>	<u>10</u>
<u>Blue clay</u>	<u>10</u>	<u>195</u>
<u>Brown clay</u>	<u>195</u>	<u>360</u>
<u>Sand & siltstone</u>	<u>360</u>	<u>574</u>

(mailing address)

WELL LOCATION:
 sec. 28 T 8 N R 2 E
1 miles E of Thompson
 (distance) (direction) (nearest town)

WELL PURPOSE: Church
 (home, irrigation, municipal, industrial)

- WELL COMPLETION DATA:
- diameter (inches) 4" x 2"
 - total depth (feet) 576
 - static water level (feet) 80 below above top of ground.
 - casing (material) Plastic, (depth) 560
4 x 2 (size) if telescope see back.
 - screen (length) 10, (depth to top) 580
2" (size), Plastic (material)
 - pump 1/2 (HP), 10 (yield gpm)
Sub. (type power)
 - electric log no (yes or no)
M. H. S. (organization running log)
 - how well bottom plugged 3/4

CODED

DRILLERS REMARKS: Madison
Well at 214 4/20/68
Made new well 7/30/69


FEB 24 1971

MISS. SD. OF WATER COUNCIL

If well telescopes please sketch and show depths.

T54

GROUND LEVEL

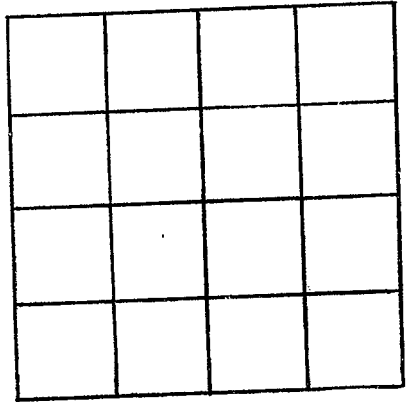

SECTION 28

Please indicate well location X.

ADDITIONAL INFORMATION

4" 190'

2" 560'

10' Plaster

560' / 570'



If more than one screen, show locations of each on sketch.