

Madison
T 58
4-67

MISSISSIPPI
BOARD OF WATER COMMISSIONERS
416 North State Street
Jackson, Mississippi 39201

CODED

WATER WELL DRILLERS LOG

April 10 1967 Bud Cresswell Madison
Date well completed firm name county well located

LANDOWNER:

CHARLES ABERNATHY
FLORA, Miss.
(mailing address)

description of formations encountered

	from	to
surface material	0	40
yellow clay	40	560
sandy shale	560	700
sand good	700	780

WELL LOCATION:

sec. 11 T. 8 N R. 2 E
4 miles West of FLORA
(distance) (direction) (nearest town)


WELL PURPOSE:

Home (home, irrigation, municipal, industrial)

WELL COMPLETION DATA:

- (1) diameter (inches) 4 x 2
- (2) total depth (feet) 780
- (3) static water level (feet) 100 ^{below} _{above} top of ground.
- (4) casing 4" (material), 35' (depth),
4" (size) if telescope see back.
- (5) screen 30 (length), 750' (depth to top)
008 (size), S.S. (material)
- (6) pump 1 (HP), (yield gpm)
Elec. (type power)
- (7) electric log No (yes or no)
(organization running log)
- (8) how well bottom plugged reduced

CODED

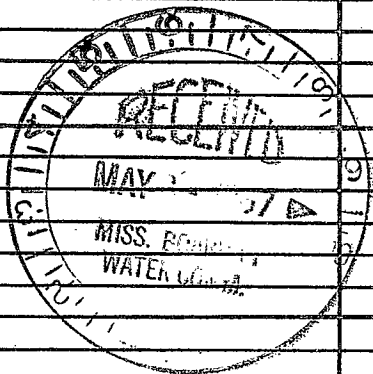

DRILLERS REMARKS:

If well telescopes please sketch and show depths.


T58

GROUND LEVEL

4"
315'

2"
435'

30"
.008

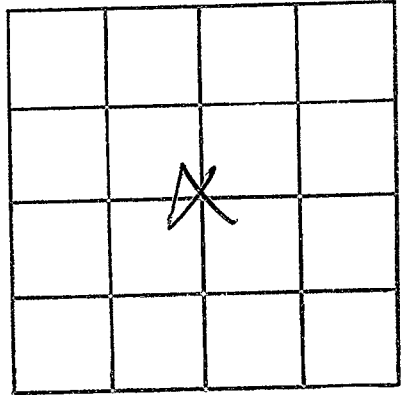

SECTION 11

Please indicate well location X.

ADDITIONAL INFORMATION

If more than one screen, show locations of each on sketch.