

Madison
T 59
11-67

MISSISSIPPI
BOARD OF WATER COMMISSIONERS
416 North State Street
Jackson, Mississippi 39201

CODED

WATER WELL DRILLERS LOG

1111 1967 Forest Drilling Madison
date well completed firm name county well located

LANDOWNER: Champion

Chemical Co.
CANTON, Miss. -
(mailing address)

WELL LOCATION:
sec. 2 T. 8 N. R. 2 E
3 miles South of Canton
(distance) (direction) (nearest town)


WELL PURPOSE: Industrial
(home, irrigation, municipal, industrial)

WELL COMPLETION DATA:

- (1) diameter (inches) 2"
- (2) total depth (feet) 519'
- (3) static water level (feet) 40' below top of ground.
- (4) casing Steel 504'
(material) (depth)
2" if telescope see back.
(size)
- (5) screen 15', 504'
(length) (depth to top)
2", 3/4" steel
(size) (material)
- (6) pump 3 2.5
(HP) (yield gpm)
220V
(type power)
- (7) electric log No
(yes or no)
2
(organization running log)
- (8) how well bottom plugged 2"
BACKWASH VALVE

description of formations encountered	from	to
<u>Brown Clay</u>	<u>0</u>	<u>37</u>
<u>Blue Clay</u>	<u>140</u>	<u>140</u>
<u>Fine Sand</u>	<u>143</u>	<u>143</u>
<u>Hard Shell</u>	<u>151</u>	<u>151</u>
<u>Rock</u>	<u>158</u>	<u>158</u>
<u>Hard Shell + Clay</u>	<u>163</u>	<u>163</u>
<u>White Sand + Clay</u>	<u>183</u>	<u>183</u>
<u>Clay + White Sand</u>	<u>204</u>	<u>204</u>
<u>Clay</u>	<u>224</u>	<u>224</u>
<u>Clay + White Sand</u>	<u>265</u>	<u>265</u>
<u>Clay</u>	<u>295</u>	<u>295</u>
<u>Fine Clay</u>	<u>307</u>	<u>307</u>
<u>Soft Clay + Sand</u>	<u>327</u>	<u>327</u>
<u>Soft Clay</u>	<u>389</u>	<u>389</u>
<u>Fine Sand + Clay</u>	<u>450</u>	<u>450</u>
<u>Clay</u>	<u>451</u>	<u>451</u>
<u>White Sand + Clay</u>	<u>471</u>	<u>471</u>
<u>Fine Sand + Clay</u>	<u>520</u>	<u>520</u>
<u>Fine Sand</u>	<u>570</u>	<u>570</u>

CODED

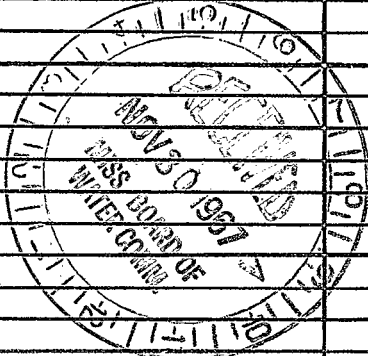


DRILLERS REMARKS: This well Pumped by Air - FURNISHED by OWNER

If well telescopes please sketch and show depths.

T59

GROUND LEVEL

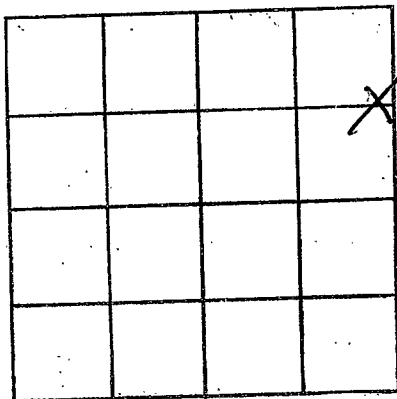

SECTION 2

Please indicate well location X.

ADDITIONAL INFORMATION

If more than one screen, show locations of each on sketch.