

MISSISSIPPI
BOARD OF WATER COMMISSIONERS
416 North State Street
Jackson, Mississippi 39201

CODED

WATER WELL DRILLERS LOG

Madison
T 60
7-68

7/10 1968 John A Davis Madison
date well completed firm name county well located

LANDOWNER:
John Lee Jr
Gluckstadt, Miss
(mailing address)

WELL LOCATION:
sec. 27 T 8 N R 2 E
S W
miles at of Gluckstadt
(distance) (direction) (nearest town)

WELL PURPOSE: home
(home, irrigation, municipal, industrial)

WELL COMPLETION DATA:

(1) diameter (inches) 2"

(2) total depth (feet) 480'

(3) static water level (feet) 70 ^{below}/_{above} top of ground.

(4) casing Galv, 460'
(material) (depth)
2"
(size) If telescope see back.

(5) screen 20', 460'
(length) (depth to top)
.007, 5.5.
(size) (material)

(6) pump 2 20
(HP) (yield gpm)
Elec
(type power)

(7) electric log no
(yes or no)
(organization running log)

(8) how well bottom plugged Pin

description of formations encountered	from	to
<u>White Clay</u>	<u>0</u>	<u>70</u>
<u>Blue Clay</u>	<u>70</u>	<u>110</u>
<u>Fine Sand</u>	<u>110</u>	<u>130</u>
<u>Blue Clay</u>	<u>130</u>	<u>190</u>
<u>Fine Sand</u>	<u>190</u>	<u>225</u>
<u>Blue clay & sand</u>	<u>225</u>	<u>460</u>
<u>Strata</u>		
<u>Sand</u>	<u>400</u>	<u>480</u>

CODED


JUL 19 1968
MISS. BOARD OF
WATER COM.

DRILLERS REMARKS:

If well telescopes please
sketch and show depths.

T60

GROUND LEVEL

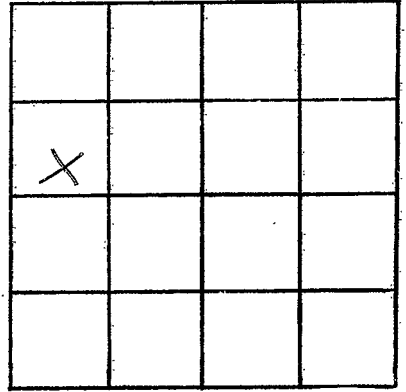

SECTION 27

Please indicate well location X.

ADDITIONAL INFORMATION

If more than one screen,
show locations of each on sketch.