

MISSISSIPPI DEPARTMENT OF NATURAL RESOURCES

Bureau of Land and Water Resources

Southport Mall

P.O. Box 10631

Jackson, Mississippi 39209

WATER WELL DRILLERS LOG

MS-GW-7-761

Coded

Madison  
T 67  
7761? 3/4/89

MARCH 4, 1988 LAUNE-CENTRAL COMPANY LINCOLN  
 date well completed firm name county well located

LANDOWNER: <u>BEAR CREEK</u>	description of formations encountered	from	to
<u>WATER ASSOCIATION</u> <u>P.O. Box 328</u> <u>CANTON, MISS. 39046</u> (mailing address)			
<u>WELL LOCATION: SE 1/4 of NE 1/4 of SE 1/4</u> <u>sec. 34 T-8 N R-2 E</u>	<u>YELLOW CLAY</u>	<u>0</u>	<u>43'</u>
<u>sec. 34 T-8 N R-2 E</u>	<u>BLUE CLAY</u>	<u>43'</u>	<u>240'</u>
<u>_____ miles _____ of _____</u> (distance) (direction) (nearest town)	<u>SANDY CLAY</u>	<u>240'</u>	<u>506'</u>
<u>WELL PURPOSE: Municipal</u> (home, irrigation, municipal, industrial)	<u>SAND</u>	<u>506'</u>	<u>584'</u>
<u>WELL COMPLETION DATA:</u>	<u>CLAY</u>	<u>584'</u>	<u>750'</u>
(1) diameter (inches) <u>12"</u>	<u>ROCK</u>	<u>750'</u>	<u>752'</u>
(2) total depth (feet) <u>1191'</u>	<u>HARD CLAY</u>	<u>752'</u>	<u>762'</u>
(3) static water level (feet) <u>193'</u> below above top of ground.	<u>SHALE</u>	<u>762'</u>	<u>891'</u>
(4) casing <u>STEEL</u> <u>1100'</u> (material) (depth)	<u>SANDY CLAY</u>	<u>891'</u>	<u>964'</u>
<u>12"</u> if telescope see back. (size) (or of 8")	<u>SHALE</u>	<u>964'</u>	<u>1040'</u>
(5) screen <u>80'</u> <u>1191'</u> (length) (depth to top)	<u>SAND &amp; SHALE STREAKS</u>	<u>1040'</u>	<u>1190'</u>
<u>8"</u> <u>Stainless Steel</u> (size) (material)	<u>HARD CLAY</u>	<u>1190'</u>	<u>1213'</u>
(6) pump <u>75</u> <u>750</u> (HP) (yield gpm)			
<u>480 Volt</u> (type power)			
(7) electric log <u>Yes</u> (yes or no)			
<u>Laune-Central Co.</u> (organization running log)			
(8) how well bottom plugged <u>Back</u> <u>Pressure Valve-Plugged</u>			
<u>DRILLERS REMARKS:</u>			
<u>Permit No. 7761</u>			

RECEIVED

AUG 15 1988

Department of Natural Resources  
 Bureau of Land & Water Resources

245-310

7/10/87


121  
 1271

1100  
 1165

1191  
 1213

If well telescopes please sketch and show depths.

GROUND LEVEL

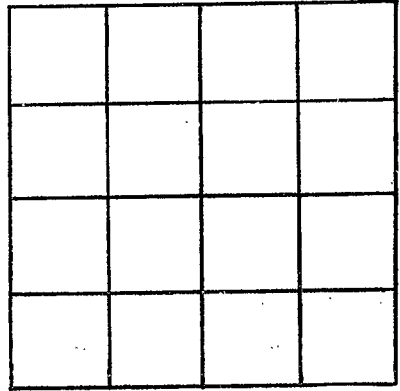

SECTION \_\_\_\_\_

Please indicate well location X.

ADDITIONAL INFORMATION

If more than one screen,  
show locations of each on sketch.