


If well telescopes please sketch and show depths.

GROUND LEVEL

If more than one screen, show location of each on sketch.

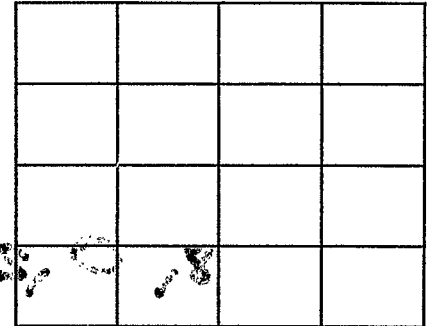

SECTION _____

Please indicate well location X.

Pump Capacity (GPM)	No. of Stages	Setting Depth	
1500	7	350	FT.
PUMP TEST			
Well yielded _____ 1500 _____ GPM with			
a drawdown of _____ 101.61 _____ ft.			
after _____ 24 _____ hours of pumping.			

LOG DATA

TYPE OF LOG RUN (Circle One):		No Log Run,
(Electric), (Gamma Ray),	Density,	Sonic, Neutron,
Other (Describe) _____		
Name of Organization Running Log		
Griner Drilling Service		

GEOLOGIC DATA (Office Use Only)

Surface Elev.	Geologic Unit	Unit Thickness	Depth to Top
Subs. SWL	Date	Analysis	Aquifer Test

Driller's Remarks
