

U
6-26-65

WATER WELL DRILLERS LOG

Date: 6/24, 1965, Driller: M^cKay County Madison
(Name)

(1) Owner of Land: C. H. Gallaway Jr
(Name)
Madison
(Address)

(2) Location: 1/4, 1/4, Sec. T. R.
6 miles SE, of Canton
(distance) (direction) (Nearest Town)

(3) Topography: (Hilly) (Flat) (Level)

(4) Purpose of Well: Home
(Domestic Irrigation, Municipal, Industrial, Other)

Description & Color of Materials Sand, Clay, Red Clay, Shell, etc.	Thick- ness Feet	Depth Feet
<u>Yellow clay</u>	<u>0</u>	<u>20</u>
<u>Yellow clay</u>	<u>20</u>	<u>40</u>
<u>Blue clay</u>	<u>40</u>	<u>120</u>
<u>Blue clay</u>	<u>120</u>	<u>160</u>
<u>Blue clay</u>	<u>160</u>	<u>220</u>
<u>Shells - clay</u>	<u>220</u>	<u>260</u>
<u>Clay - sand mixed</u>	<u>260</u>	<u>380</u>
<u> " " " "</u>	<u>380</u>	<u>420</u>
<u>Fine Sand</u>	<u>420</u>	<u>460</u>
<u>med Sand</u>	<u>460</u>	<u>500</u>

Information upon completion of well:

(1) Diameter 2 inches.

(2) Total Depth 500 feet.

(3) Water Level 74 feet below top of ground.

(4) Cased to , Size .

(5) Screen: Size 007, Length 20.


(6) Were any formations sealed against pollution?
 yes, no.

3 HP air unit
in Canton

If YES depth of formation

Why

Drillers Remarks:

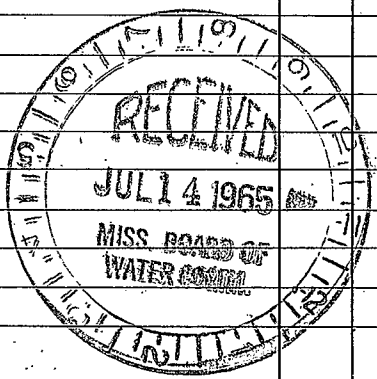

(Use Back Side)

Well No.

