

U
4-26-64

WATER WELL DRILLERS LOG

Date: 4-26, 1964, Driller: McKAY County MADISON
(Name)

(1) Owner of Land: 600. H. MOORE FARMS
(Name)
CANTON MISS
(Address)

(2) Location: 1/4, 1/4, Sec. T R
10 miles SE of CANTON
(distance) (direction) (Nearest Town)

(3) Topography: (Hilly) (Flat) (Level)

(4) Purpose of Well: FARM
(Domestic Irrigation
Municipal, Industrial, Other)

Information upon completion of well:

(1) Diameter 4 inches. X 2 1/2

(2) Total Depth 955 feet.

(3) Water Level 159 feet below top of ground.

(4) Cased to 357, Size 4"

(5) Screen: Size 008, Length 34


(6) Were any formations sealed against pollution?
no yes, no.

Description & Color of Materials Sand, Clay, Red Clay, Shell, etc.	Thick- ness Feet	Depth Feet
Red Sand	0	20
Blue Clay	20	40
Blue Clay	40	180
MOODY BRANCH	180	220
Fine Sandy Clay	220	240
Fine Sand - Clay	240	340
Light Sand - Clay STA	340	360
" " "	360	380
" " "	380	400
Brown Clay	400	440
Brown Clay	440	520
Rock Stray Clay	520	540
Stray Sand and Clay	540	600
Sandy - Sandy Clay	600	620
Rock - Sand Stray	620	640
Sandy Clay	640	680
" " "	680	700
Sandy Clay	700	760
Sandy Clay	760	820
Sandy Clay	820	830
Fine Sand	830	840
med Sand	840	855
med Sand	855	935
med to Fine	935	955
Green Fine Sand.	955	956

If YES depth of formation _____

Why _____

Drillers Remarks: _____

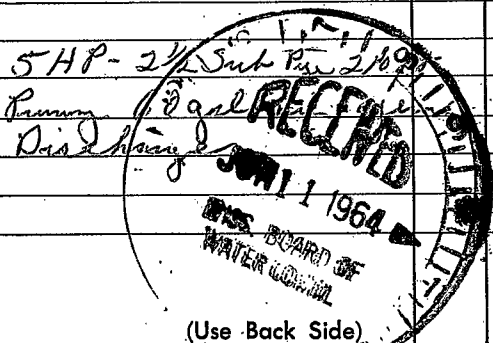

(Use Back Side)

Well No.

1945

Faint, illegible text, possibly bleed-through from the reverse side of the page.

