

U

K-30-65

WATER WELL DRILLERS LOG

Date: 1/30, 1965, Driller: M. KAY County: MADISON

(1) Owner of Land: MR. Franzen (Name) Canton Miss (Address)

(2) Location: 1/4, 1/4, Sec. T R, 12 miles SE of CANTON (distance) (direction) (Nearest Town)

(3) Topography: (Hilly) (Flat) (Level)

(4) Purpose of Well: Home (Domestic Irrigation Municipal, Industrial, Other)

Table with 4 columns: Description & Color of Materials, Thickness Feet, Depth Feet. Rows include Red Clay, Blue Clay, Sandy Shale, Gumbo, Sand Stone - Shale, Med to Fine Sand, Sand Stone - Shale.

Information upon completion of well:

(1) Diameter 2 inches.

(2) Total Depth 620 feet.

(3) Water Level 95 feet below top of ground.

(4) Cased to, Size

(5) Screen: Size 007, Length 20ft


(6) Were any formations sealed against pollution? yes, no.

If YES depth of formation

Why

Drillers Remarks:

2 1/2 ft Cas Pipe, Screen Set at 580 to 600 ft, 126 ft 1/4 in Pipe, 3/4 # P. 42 Tank.

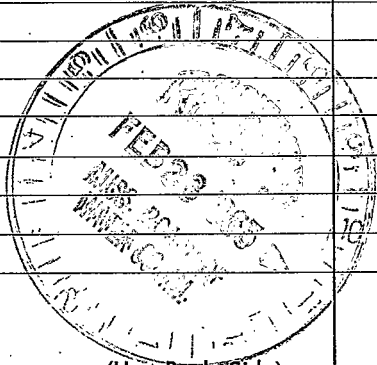

(Use Back Side)

Well No.

1950

1. The first part of the report deals with the general situation of the country and the progress of the work during the year. It is divided into two main sections: the first section deals with the general situation of the country and the progress of the work during the year, and the second section deals with the results of the work during the year.

2. The second part of the report deals with the results of the work during the year. It is divided into two main sections: the first section deals with the results of the work during the year, and the second section deals with the results of the work during the year.

3. The third part of the report deals with the results of the work during the year. It is divided into two main sections: the first section deals with the results of the work during the year, and the second section deals with the results of the work during the year.