

MADISON MISSISSIPPI BOARD OF WATER COMMISSIONERS

6-21-65 WATER WELL DRILLERS LOG

Date: 6/21, 1965, Driller: McKay County Madison

(1) Owner of Land: Archie
(Name)
Madison
(Address)

(2) Location: 1/4, 1/4, Sec. T R
6 miles S E, of Linton
(distance) (direction) (Nearest Town)

(3) Topography: C
(Hilly) (Flat) (Level)

(4) Purpose of Well: Home
(Domestic Irrigation Municipal, Industrial, Other)

Description & Color of Materials Sand, Clay, Red Clay, Shell, etc.	Thick- ness Feet	Depth Feet
<u>White Clay</u>	<u>0</u>	<u>20</u>
<u>yellow clay</u>	<u>20</u>	<u>40</u>
<u>Blue Clay</u>	<u>40</u>	<u>60</u>
<u>" " "</u>	<u>60</u>	<u>80</u>
<u>" " Shell</u>	<u>80</u>	<u>120</u>
<u>Blue Clay</u>	<u>120</u>	<u>160</u>
<u>" " "</u>	<u>160</u>	<u>220</u>
<u>Rock Star Clay</u>	<u>220</u>	<u>240</u>
<u>" " Shell</u>	<u>240</u>	<u>300</u>
<u>Fine Sand</u>	<u>300</u>	<u>360</u>
<u>Clay - Sand Str</u>	<u>360</u>	<u>380</u>
<u>" " "</u>	<u>380</u>	<u>440</u>
<u>Med Sand</u>	<u>440</u>	<u>460</u>
<u>" " "</u>	<u>460</u>	<u>500</u>

Information upon completion of well:

(1) Diameter 2 inches.

(2) Total Depth 500 feet.

(3) Water Level 77 feet below top of ground.

(4) Cased to _____, Size _____


(5) Screen: Size 007, Length 20

(6) Were any formations sealed against pollution?
 _____ yes, no.

Get Pump 82 tank.

If YES depth of formation _____
 Why _____

Drillers Remarks: _____

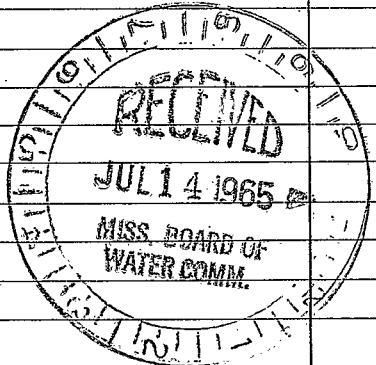

(Use Back Side)

Well No.

