

WATER WELL DRILLERS LOG

3-1-62

Date: 3/1, 1962, Driller: M. C. Kay County Madison

(1) Owner of Land: Carrol Roberson
 (Name)
Jackson Miss
 (Address)

(2) Location: $\frac{1}{4}$, $\frac{1}{4}$, Sec. T. R.
1 MI of NATCHEZ TOWN
8 miles SE of Canton
 (distance) (direction) (Nearest Town)

(3) Topography: (Hilly) (Flat) (Level)

(4) Purpose of Well: Home
 (Domestic Irrigation
 Municipal, Industrial, Other)

Description & Color of Materials Sand, Clay, Red Clay, Shell, etc.	Thick- ness Feet	Depth Feet
Red Clay - Sand	0	10
Sandy white Clay	10	21
White to Coarse Sand	21	30
Blue Clay	30	42
" " "	42	63
Shell - muddy blue	63	74
Clay	74	84
Brown Clay	84	100
Brown Clay	100	108
Red White	108	109
Brown Clay	109	126
" " "	126	147
Sandy - Clay	147	168
" " "	168	189
" " "	189	210
Sand - Fine	210	231
Sand	231	241
Clay - Sand	241	252
" " "	252	273
" " "	273	294
Coarse Sand	294	315
Coarse Sand	315	327

Information upon completion of well:

(1) Diameter 2 inches.

(2) Total Depth 327 feet.

(3) Water Level 93 feet below top of ground.

(4) Cased to _____, Size _____

(5) Screen: Size 00 6, Length 10

(6) Were any formations sealed against pollution?
 _____ yes, no.


If YES depth of formation _____

Why _____

Drillers Remarks: _____

Set 206 x 10 Screen
 S.S.

3 H.P. air pump

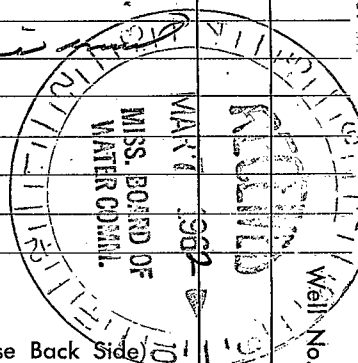

(Use Back Side)

