

MADISON

U 14

5-30-66

WATER WELL DRILLERS LOG

CODED

MADISON

Date: 30 May, 1966, Driller: WATERWELLS, INC. County: HINDS

(Name)

(1) Owner of Land: State Game & Fish Comm.

(Name)

Jackson, Miss

(Address)

(2) Location: SW 1/4, NW 1/4, Sec. 23 T8R3E

miles of (distance) (direction) (Nearest Town)

(3) Topography: Hilly (Hilly) (Flat) (Level)

(4) Purpose of Well: Laboratory Building (Domestic Irrigation) (Municipal) (Industrial) (Other)

Description & Color of Materials Sand, Clay, Red Clay, Shell, etc.	Thick- ness Feet	Depth Feet
Weathered clay	0	12
Yellowish coarse sand	12	37
Bluish clay	37	188
Solf black sandy shale	188	216
Shale - sand streaks	216	420
Fine to Medium sand	420	510
Shale - solf rock streaks	510	660
Fine sand shale streaks	660	795
Medium to coarse sand	795	898TD

Information upon completion of well:


- (1) Diameter 4 x 2 inches.
- (2) Total Depth 898 feet.
- (3) Water Level 145 feet below top of ground.
- (4) Cased to 898, Size 4 x 2, 306' of 4"
- (5) Screen: Size 2, Length 40
- (6) Were any formations sealed against pollution?
X yes, no.

If YES depth of formation top 10'
Why Surface Seal

Drillers Remarks: top of screens 837'

Pumping 25 GPM

CODED

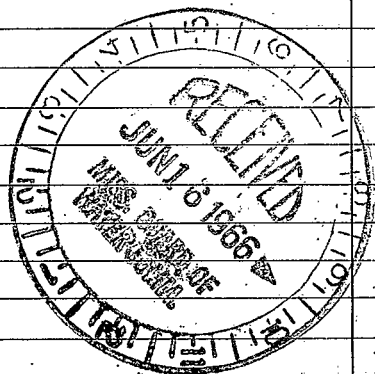

(Use Back Side)

Well No.

100
101

102
100