

CODED

Rev 7/28/69

OK 1/8/69

Madsen
U 15
6-17-69

MISSISSIPPI
 BOARD OF WATER COMMISSIONERS
 416 North State Street
 Jackson, Mississippi 39201

WATER WELL DRILLERS LOG

date well completed 6/17/69 ¹⁹69 firm name Forest Drilling Madsen county well located

LANDOWNER: C. H. Holloway Jr.
Canton Miss.
 (mailing address)

WELL LOCATION:
 sec. 15 T. 8 N. R. 3 E
6 miles SE Benton
 (distance) (direction) (nearest town)
Miss

WELL PURPOSE: home
 (home, irrigation, municipal, industrial)

WELL COMPLETION DATA:

(1) diameter (inches) 2"

(2) total depth (feet) 471'

(3) static water level (feet) 120' below
 above
 top of ground.

(4) casing Galv 456'
 (material) (depth)
2" if telescope see back.
 (size)

(5) screen 15' 456'
 (length) (depth to top)
2" Stainless Steel
 (size) (material)

(6) pump Bay Owner
 (HP) (yield gpm)

(type power)

(7) electric log no
 (yes or no)
 (organization running log)

(8) how well bottom plugged 2" Borehole
Values

description of fomations encountered	from	to
	<u>Brown clay</u>	<u>0</u>
<u>Red sand</u>	<u>13</u>	<u>24</u>
<u>Clay</u>	<u>24</u>	<u>184</u>
<u>Clay & stb lime</u>	<u>184</u>	<u>204</u>
<u>lumpy shale</u>	<u>204</u>	<u>224</u>
<u>shale</u>	<u>224</u>	<u>286</u>
<u>shale + stb fine sand</u>	<u>286</u>	<u>354</u>
<u>Fine sand</u>	<u>354</u>	<u>415</u>
<u>sand + stb clay</u>	<u>415</u>	<u>420</u>
<u>Fine sand</u>	<u>420</u>	<u>430</u>
<u>Fine sand + stb clay</u>	<u>430</u>	<u>442</u>
<u>Fine sand</u>	<u>442</u>	<u>472</u>


JUL 28 1969

MISS. BD. OF
 WATER COMM.

DRILLERS REMARKS:

If well telescopes please sketch and show depths.

GROUND LEVEL

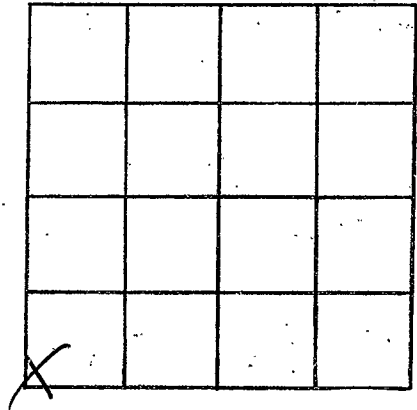

SECTION 15

Please indicate well location X.

ADDITIONAL INFORMATION

Lined area for additional information.

If more than one screen, show locations of each on sketch.