

Madison

U 16

2-10-70

MISSISSIPPI
 BOARD OF WATER COMMISSIONERS
 416 North State Street
 Jackson, Mississippi 39201

WATER WELL DRILLERS LOG

2/10 1970 Forest Drilling Madison
 date well completed firm name county well located

LANDOWNER: Pearl River

description of formations encountered

from

to

Water Supply District
 Hwy 13 + Patchy Road
 Haystack Landing
 (mailing address)

yellow clay	0	19
Hard blue clay	19	167
Soft blue clay	167	187
Soft blue clay + shell	187	207
Blue clay	207	267
Soft shale	267	287
Stb. shale + silt	287	306
Stb. shale + sand	306	326
Fine sand + stb. shale	326	346
Shale	346	440
Fine sand + stb. shale	440	460
Fine sand + stb. lignite	460	467
Fine sand	467	492
Shale	492	507

WELL LOCATION:

sec. 22 T 8 N R 3 E
 6 miles SE of Canton
 (distance) (direction) (nearest town)

WELL PURPOSE: Community
 (home, irrigation, municipal, industrial)

WELL COMPLETION DATA:

- (1) diameter (inches) 4" x 2"
- (2) total depth (feet) 502'
- (3) static water level (feet) 86' below top of ground.
- (4) casing steel, 482' (material) (depth) 277'-4" 225'-2" (size) if telescope see back.
- (5) screen 20', 482' (length) (depth to top) 2" stainless steel (size) (material)
- (6) pump 3-stage 24 (HP) (yield gpm)
 Elect (type power)
- (7) electric log Yes (yes or no)
 Miss. Geological (organization running log)
- (8) how well bottom plugged 2" Backward Valve

CODED

CODED

CODED

CODED

FEB 27 1970


MISS. Bd. of Water Comm.

DRILLERS REMARKS: 10'-2"

Fail pipe under screen

If well telescopes please sketch and show depths.

GROUND LEVEL

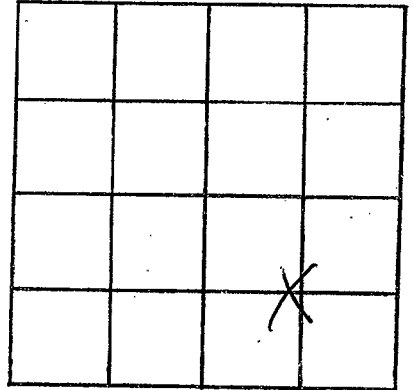

SECTION 22

Please indicate well location X.

ADDITIONAL INFORMATION

If more than one screen,
show locations of each on sketch.