

Madison
 U17
 12-70

MISSISSIPPI
 BOARD OF WATER COMMISSIONERS
 416 North State Street
 Jackson, Mississippi 39201

CODED

WATER WELL DRILLERS LOG

12-28 1970 John Davis Madison
 date well completed firm name county well located

LANDOWNER:	description of formations encountered	from	to
American Legion Club house (mailing address)			
WELL LOCATION:	Finest coarse white sand	5	30
sec. 4 T. 20 N. R. 4 E. S. W. 7 miles SE of Canton (distance) (direction) (nearest town)			
WELL PURPOSE: Domestic (home, irrigation, municipal, industrial)			
WELL COMPLETION DATA:			
(1) diameter (inches) 2"			
(2) total depth (feet) 30			
(3) static water level (feet) 7 ^{below} / _{above} top of ground.			
(4) casing Galv. 25' (material) (depth) 2" (size) if telescope see back.			
(5) screen 5' 25' (length) (depth to top) .007 (size) Stainless (material)			
(6) pump 1/2 (HP) 7 (yield gpm) Elec (type power)			
(7) electric log NO (yes or no) (organization running log)			
(8) how well bottom plugged Drop pin			
DRILLERS REMARKS:			


CODED

JAN 7 - 1971

Miss. Bd. of
 WATER COMMISSIONERS

If well telescopes please sketch and show depths.

GROUND LEVEL

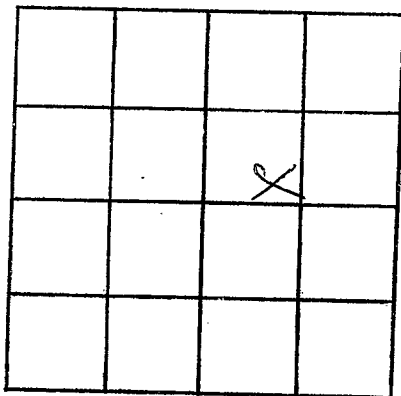

SECTION 4

Please indicate well location X.

ADDITIONAL INFORMATION

If more than one screen,
show locations of each on sketch.