

U 18  
8-15-62

WATER WELL DRILLERS LOG

**CODED**

Date: Aug 15, 1962, Driller: M<sup>c</sup> Kay County Madison  
(Name)

(1) Owner of Land: J. J. Waller  
(Name)  
Madison Miss  
(Address)

(2) Location: 1/4, 1/4, Sec. 29 T 8 R 3E,  
32  
10 miles SE of Clinton  
(distance) (direction) (Nearest Town)

(3) Topography:  (Hilly)  (Flat)  (Level)

(4) Purpose of Well: Home  
(Domestic Irrigation  
Municipal, Industrial, Other)

Description & Color of Materials Sand, Clay, Red Clay, Shell, etc.	Thick- ness Feet	Depth Feet
<u>yellow clay</u>	<u>0</u>	<u>21</u>
<u>Blue Clay</u>	<u>21</u>	<u>42</u>
<u>Blue Clay</u>	<u>42</u>	<u>63</u>
<u>Blue Clay</u>	<u>63</u>	<u>252</u>
<u>Muddy Brackish</u>	<u>252</u>	<u>273</u>
<u>Sandy Clay</u>	<u>273</u>	<u>294</u>
<u>Rock</u>	<u>294</u>	<u>294 1/2</u>
<u>Sandy Clay</u>	<u>294 1/2</u>	<u>315</u>
<u>.. ..</u>	<u>315</u>	<u>420</u>
<u>Lignite Sand</u>	<u>420</u>	<u>441</u>
<u>.. ..</u>	<u>441</u>	<u>483</u>
<u>Fine Sand</u>	<u>483</u>	<u>570</u>
<u>Med Sand</u>	<u>570</u>	<u>570</u>

Information upon completion of well:

(1) Diameter 2 inches.

(2) Total Depth 570 feet.

(3) Water Level 91 feet below top of ground.

(4) Cased to \_\_\_\_\_, Size \_\_\_\_\_


(5) Screen: Size 006, Length 50

(6) Were any formations sealed against pollution?  
\_\_\_\_\_ yes,  no.

Set Screen 570 ft

3HP air unit

**CODED**

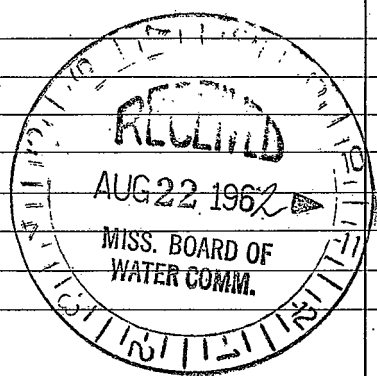

(Use Back Side)

Well No.

