

MADISON MISSISSIPPI BOARD OF WATER COMMISSIONERS

U20
9-5-63

WATER WELL DRILLERS LOG

CODED

11

Date: 9/5, 1963, Driller: McKAY
(Name)

County MADISON

- (1) Owner of Land: HAL BEALE
(Name)
Rt 3 Canton
(Address)
- (2) Location: 1/4, 1/4, Sec. 5 T8 R4E
10 miles SE, of Canton
(distance) (direction) (Nearest Town)
- (3) Topography: (Hilly) (Flat) (Level)
- (4) Purpose of Well: (Domestic Irrigation, Municipal, Industrial, Other)

Description & Color of Materials Sand, Clay, Red Clay, Shell, etc.	Thick- ness Feet	Depth Feet
<u>Yellow clay</u>	<u>0</u>	<u>21</u>
<u>Red clay</u>	<u>27</u>	<u>32</u>
<u>Blue clay</u>	<u>32</u>	<u>252</u>
<u>Fine Sand</u>	<u>252</u>	<u>315</u>
<u>Med Sand</u>	<u>315</u>	<u>357</u>
<u>3HP Airum</u>		

Information upon completion of well:


- (1) Diameter 2 inches.
- (2) Total Depth 357 feet.
- (3) Water Level _____ feet below top of ground.
- (4) Cased to 82, Size _____.
- (5) Screen: Size 007, Length 20.
- (6) Were any formations sealed against pollution?
_____ yes, no.

If YES, depth of formation _____

Why _____

Drillers Remarks: _____

CODED

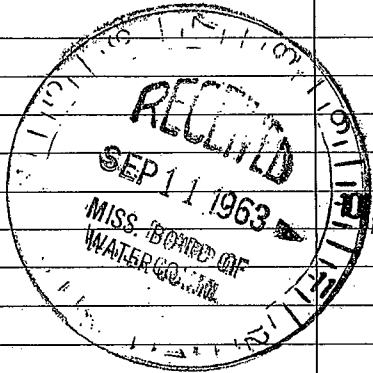

(Use Back Side)

Well No.

100

101

102

200