

W 421

CODED

4-26-65

WATER WELL DRILLERS LOG

Date: 4/26, 1965, Driller: MCKAY County: MADISON

(1) Owner of Land: Leon Davis
 (Name)
Canton Miss
 (Address)

(2) Location: 1/4, 1/4, Sec. 7 T8 R3E,
5 miles SE of Canton
 (distance) (direction) (Nearest Town)

(3) Topography: (Hilly) (Flat) (Level)

(4) Purpose of Well: Home
 (Domestic Irrigation
 Municipal, Industrial, Other)

Description & Color of Materials Sand, Clay, Red Clay, Shell, etc.	Thick- ness Feet	Depth Feet
<u>White Clay</u>	<u>0</u>	<u>0</u>
<u>Blue clay</u>	<u>21</u>	<u>42</u>
<u>Blue clay</u>	<u>42</u>	<u>120</u>
<u>Sandy Clay</u>	<u>720</u>	<u>140</u>
<u>Blue clay</u>	<u>140</u>	<u>240</u>
<u>Brown shale</u>	<u>240</u>	<u>340</u>
<u>Sand</u>	<u>340</u>	<u>360</u>
<u>Med. Sand</u>	<u>360</u>	<u>380</u>

Information upon completion of well:

(1) Diameter 2 inches.

(2) Total Depth 380 feet.

(3) Water Level 68 feet below top of ground.

(4) Cased to ✓, Size 0

(5) Screen: Size 007, Length 10ft

(6) Were any formations sealed against pollution?
no, yes.


Set 3 HP air unit

CODED

If YES depth of formation _____

Why _____

Drillers Remarks: _____

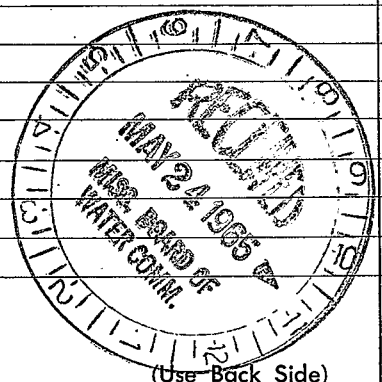

Well No.

