

MADISON MISSISSIPPI BOARD OF WATER COMMISSIONERS

U 22

5-22-65

WATER WELL DRILLERS LOG

Madison
CODED

Date: 5/22, 1965, Driller: Forest Drilling Co. (Name)

MONA WELLS

(1) Owner of Land: O. M. Kenkin
(Name)
Canton, Miss
(Address)

(2) Location: 1/4, 1/4, Sec. 38 RE
3 miles S/E of Canton
(distance) (direction) (Nearest Town)

(3) Topography: (Hilly) (Flat) (Level)

(4) Purpose of Well: Home + cattle farm
(Domestic Irrigation, Municipal, Industrial, Other)

Description & Color of Materials Sand, Clay, Red Clay, Shell, etc.	Thick- ness Feet	Depth Feet
Brown Clay		32
Blue Clay		67
Shell + Rock		72
Shell + mky. Sand		98
Clay + Rock		102
Clay + sh. fine sand		112
Fine Sand		118
Clay		122
Hard Clay		142
Soft Sand + sh. fine sand		182
Clay + sh. fine sand		202
Fine Sand + sh. Clay		222
Clay + sh. fine sand		252
Fine Sand		365

Information upon completion of well:

(1) Diameter 2 inches.

(2) Total Depth 365 feet.

(3) Water Level 63 feet below top of ground.

(4) Cased to 355, Size 2"


(5) Screen: Size 2", Length 10ft.

(6) Were any formations sealed against pollution?
 yes, no.

CODED

If YES depth of formation _____
 Why _____

Drillers Remarks: _____

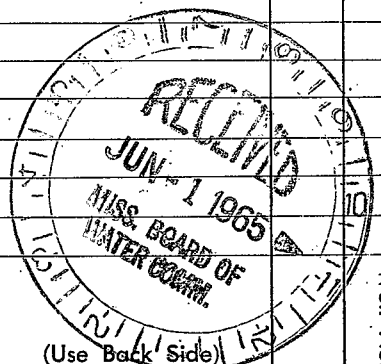

Well No.

(Use Back Side)

