

MADISON MISSISSIPPI BOARD OF WATER COMMISSIONERS

423
2-3-66

WATER WELL DRILLERS LOG

CODED

Date: 2/3, 1966, Driller: Forest Drilling County Madison
(Name)

(1) Owner of Land: W.T. Kernop
(Name)
Rt 3 Canton, Miss
(Address)

(2) Location: 1/4, 1/4, Sec. 15 T8 R3,
6 miles East of Canton
(distance) (direction) (Nearest Town)

(3) Topography: (Hilly) (Flat) (Level)

(4) Purpose of Well: Home
(Domestic Irrigation
Municipal, Industrial, Other)

Description & Color of Materials Sand, Clay, Red Clay, Shell, etc.	Thick- ness Feet	Depth Feet
Brown Clay		25
Blue Clay		142
Clay + 1/4" Rock		152
Clay + 1/4" Shell		182
Clay + 1/4" Mky Sand		212
Fine Sand + 1/4" Clay		222
Clay + 1/4" Mky Sand		292
Clay		302
Clay + Mky sand		332
Clay		347
Fine Sand + 1/4" Clay		352
Clay		367
Fine Sand		377
Fine Sand + 1/4" Clay		397
Fine Sand		407
Clay		414
Fine Sand		420
Fine Sand + 1/4" Clay		430
Fine Sand		472

Information upon completion of well:

(1) Diameter 2 inches.

(2) Total Depth 472 feet.

(3) Water Level 103 feet below top of ground.

(4) Cased to 457, Size 2"

(5) Screen: Size 2", Length 15 ft.


(6) Were any formations sealed against pollution?
 yes, no.

CODED

If YES depth of formation _____

Why _____

Drillers Remarks: _____

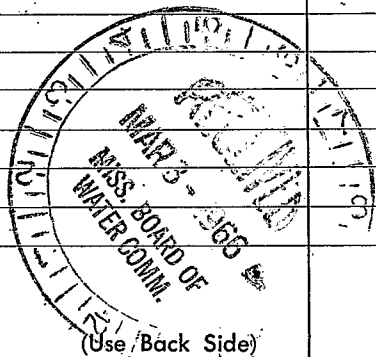

Well No.

