

Madison
 U25
 11-66
 Date: 1/1/30, 1966

WATER WELL DRILLERS LOG

CODED

Driller: M. E. Kay County Madison
 (Name)

(1) Owner of Land: J. S. Lowner
 (Name)
Jackson Miss
 (Address)

(2) Location: SE 1/4, NE 1/4, Sec. 2 T8R4E5
8 miles SE of Centerville
 (distance) (direction) (Nearest Town)

(3) Topography: (Hilly) (Flat) (Level)

(4) Purpose of Well: Home
 (Domestic Irrigation
 Municipal, Industrial, Other)

Description & Color of Materials Sand, Clay, Red Clay, Shell, etc.	Thick- ness Feet	Depth Feet
<u>Red clay</u>	<u>10</u>	<u>10</u>
<u>Yellow clay</u>	<u>10</u>	<u>20</u>
<u>Blue clay</u>	<u>180</u>	<u>200</u>
<u>Sand - Shale</u>	<u>30</u>	<u>230</u>
<u>Blue clay</u>	<u>10</u>	<u>240</u>
<u>Blue clay</u>	<u>60</u>	<u>300</u>
<u>Brown Shale</u>	<u>60</u>	<u>360</u>
<u>Medium Sand</u>	<u>60</u>	<u>420</u>

Information upon completion of well:

(1) Diameter 2 inches.

(2) Total Depth 420 feet.

(3) Water Level 77 feet below top of ground.

(4) Cased to 40', Size 2"

(5) Screen: Size 007, Length 20

(6) Were any formations sealed against pollution?
 yes, no.


3HP. air unit

CODED

If YES depth of formation _____

Why _____

Drillers Remarks: _____

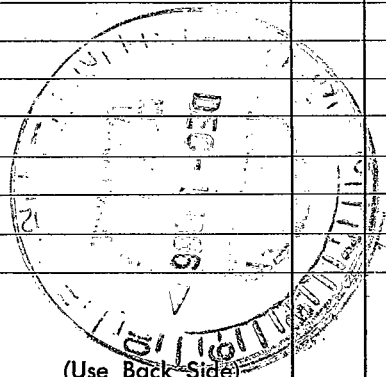

(Use Back-Side)

Well No.

100

100

100