

MADISON

U 26

2.15-74

MISSISSIPPI BOARD OF WATER COMMISSIONERS  
416 North State Street  
Jackson, Mississippi 39201

CODED

WATER WELL DRILLERS LOG

Feb-15

19

74 John A Davis

Madison

date well completed

firm name

county well located

LANDOWNER: Ira Jones

Canton

Rural Route  
(mailing address)

WELL LOCATION:

sec. 5 T-8 N R-3 E  
9 miles South of Canton  
(distance) (direction) (nearest town)

WELL PURPOSE:  
(home, irrigation, municipal, industrial)

WELL COMPLETION DATA:

- (1) diameter (inches) 2"
- (2) total depth (feet) 330'
- (3) static water level (feet) 60 below top of ground.
- (4) casing PVC 310 (material) (depth)
- (5) screen 20' (length) 330 (depth to top)  
10 slot PVC (size) (material)
- (6) pump 3 (HP) 30 (yield gpm)  
Electric (type power)
- (7) electric log  (yes or no)

(organization running log)

(8) how well bottom plugged *firm*

description of formations encountered	from	to
light clay	0	40
light blue	40	75
<del>light blue</del>		
blue clay	75	90
Muda Branch	90	105
blue	105	175
sand streaks	175	250
sand fine	250	275
blue	275	300
sand streak	300	330


DRILLERS REMARKS:

MISS. Bd. OF WATER COMM.

MAR 10 1974

If well telescopes please sketch and show depths.

GROUND LEVEL

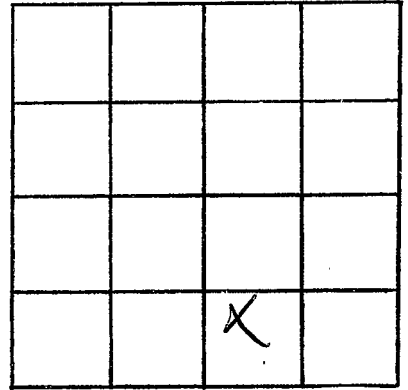

SECTION 5

Please indicate well location X.

ADDITIONAL INFORMATION

If more than one screen,  
show locations of each on sketch.