

4-32  
 MADISON  
 763  
 4-4-79  
 Log #252

GW-3705  
 MISSISSIPPI  
 BOARD OF WATER COMMISSIONERS  
 416 North State Street  
 Jackson, Mississippi 39201  
 GW-3705  
 WATER WELL DRILLERS LOG  
 Bruce Berryman -  
 Greenwood.

CODED

April 4 1979 date well completed  
 firm name  
 Madison county well located

LANDOWNER: Deerfield Golf Club  
 c/o Mr. J.D. Rankin,  
 Rt. 2. Box 329  
 CANTON. Ms. 39046

(mailing address)

WELL LOCATION:

sec. 24 T 8 N R 2 E  
 19 S 3 W  
 8 miles S of CANTON  
 (distance) (direction) (nearest town)

WELL PURPOSE: GOLF course.  
 (home, irrigation, municipal, industrial)

WELL COMPLETION DATA:

- (1) diameter (inches) 8" x 6"
- (2) total depth (feet) 555'
- (3) static water level (feet) 45' below top of ground.
- (4) casing 6" blk. 370 ft. (material) (depth) 104, ft. (size) if telescope see back.
- (5) screen 81 ft. (length) (depth to top) 20' 4" .006 (size) (material) 61 ft. .008 stainless steel
- (6) pump 30 (HP) 450 (yield gpm)
- Electric (type power)
- (7) electric log Yes (yes or no)

Miss. Geological Economic and Topographical Survey B.P.V.  
 (8) how well bottom plugged

Description of formations encountered	from	to
Mellow Clay	0	30
Blue clay	30	140
Sandy shale	140	160
Shale & str. sand	160	180
Shale & rock	180	200
Shale & Str. sand	200	380
Sand	380	470
Clay	470	490
Sand	490	510
Shale	510	600

elv 265  
 wl 260

370  
 69  
 434  
 66  
 781  
 330  
 54  
 414 T  
 61  
 475  
 23  
 497 T  
 30

CODED

Miss. Board of Water Comm.

JUL 9 1979

DRILLERS REMARKS:

(K)

If well telescopes please sketch and show depths.


385 - 514

413 - 474  
ci

T63

495' 515


GROUND LEVEL

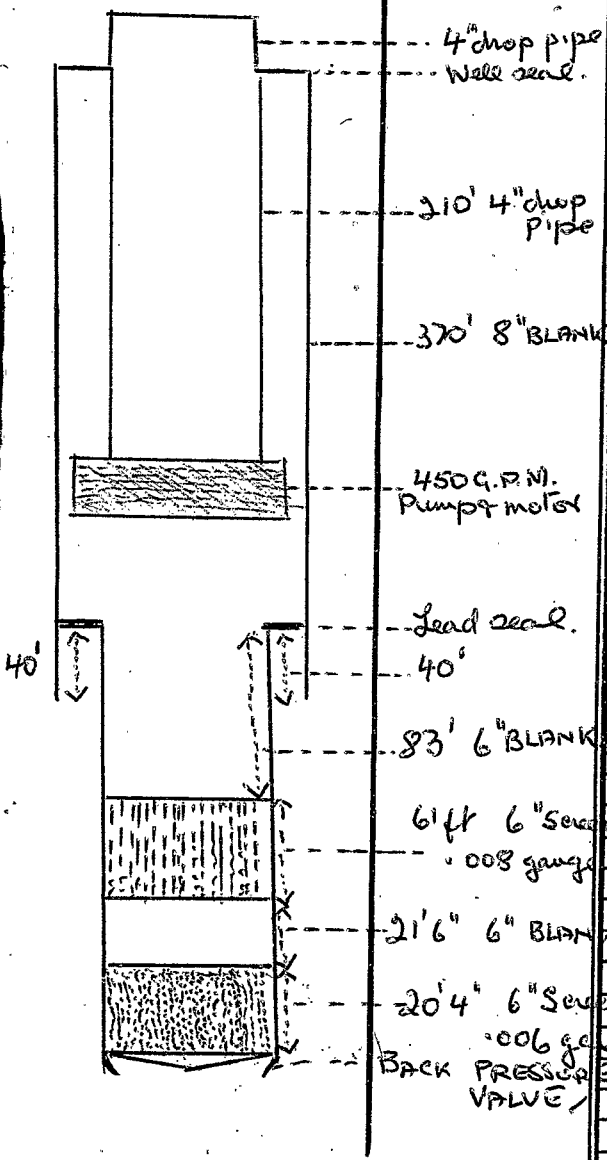

SECTION 24

Please indicate well location X.

ADDITIONAL INFORMATION

376  
-46  
330  
83  
413

If more than one screen, show locations of each on sketch.