

MISSISSIPPI DEPARTMENT OF NATURAL RESOURCES

Bureau of Land and Water Resources

Southport Mall

P.O. Box 10631

Jackson, Mississippi 39209

WATER WELL DRILLERS LOG

U 2000
Madison
7-24-85

7-24
date well completed

1985
firm name

Madison
county well located

LANDOWNER: Billy Dickson

Carnton miss
(mailing address)

WELL LOCATION:

sec. 11 T. 8 N. 3 S. R. 7 E. 3 W.
6 miles SE of Carnton
(distance) (direction) (nearest town)

WELL PURPOSE:

(home) irrigation, municipal, industrial

WELL COMPLETION DATA:

- (1) diameter (inches) 2"
- (2) total depth (feet) 290'
- (3) static water level (feet) 94' below top of ground.
- (4) casing PVC 290'
(material) (depth)
2' if telescope see back.
(size)
- (5) screen 10' 280'
(length) (depth to top)
2" PVC
(size) (material)
- (6) pump 1 6
(HP) (yield gpm)
Electric
(type power)
- (7) electric log NU
(yes or no)

(organization running log)

(8) how well bottom plugged Screen

description of formations encountered

from to

<u>Red Dirt</u>	<u>0</u>	<u>8</u>
<u>Red Sand</u>	<u>8</u>	<u>22</u>
<u>Grey Chalk</u>	<u>22</u>	<u>158</u>
<u>Thin Grey sand</u>	<u>158</u>	<u>170</u>
<u>Grey Chalk</u>	<u>170</u>	<u>240</u>
<u>White sand</u>	<u>240</u>	<u>290</u>


DRILLERS REMARKS:

RECEIVED
OCT - 7 1985

Department of Natural Resources
Bureau of Land & Water Resources

If well telescopes please
sketch and show depths.

GROUND LEVEL

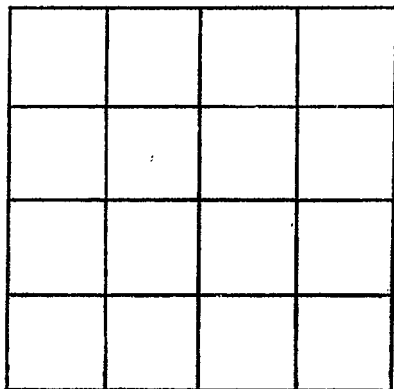

SECTION _____

Please indicate well location X.

ADDITIONAL INFORMATION

If more than one screen,
show locations of each on sketch.