

7-20-63 WATER WELL DRILLERS LOG

Date: 7/20, 1963, Driller: Just Only Inc County Jeff
 (Name)

(1) Owner of Land: R. W. Stuhling
 (Name)
Box 4237 Jackson, Miss
 (Address) 15, 26, 22, B 15
28, 35, 33

(2) Location: 1/4, ? 1/4, Sec. 9 T. 7 R. 16
8 miles West of Madison
 (distance) (direction) (Nearest Town)

(3) Topography: _____
 (Hilly) (Flat) (Level)

(4) Purpose of Well: Home use
 (Domestic Irrigation Municipal, Industrial, Other)

Description & Color of Materials Sand, Clay, Red Clay, Shell, etc.	Thick-ness Feet	Depth Feet
Clay	0	30
Blue Clay		330
B. Shale		410
Shale + Sth Rock		442
Fine shells & sand		492
Ordry. Sand		472
Fine Sand		492
Fine Sand + Shale		533
Shale + Sth sand		575
Sth sand + shale		595
" " Shale + silt		600
Fine Sand + silt		637
Fine Sand		659
Fine Sand + Shale		701
Shale		719
Sand + Sth Shale		741
Fine sand		749

Information upon completion of well:

(1) Diameter 2" inches.


(2) Total Depth 749 feet.

(3) Water Level 188 feet below top of ground.

(4) Cased to 729, Size 2"

(5) Screen: Size 2", Length 20 ft.

(6) Were any formations sealed against pollution?
 _____ yes, X no.

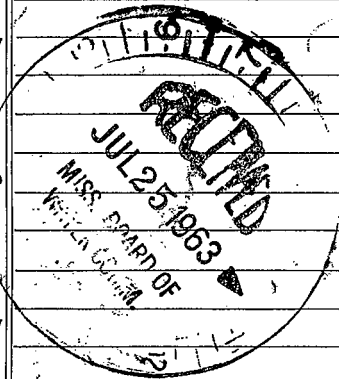

If YES depth of formation _____

Why _____

Drillers Remarks: _____

(Use Back Side)

Well No.

