

V1
 V 1
 MADISON
 7-23-73

MISSISSIPPI
 BOARD OF WATER COMMISSIONERS
 416 North State Street
 Jackson, Mississippi 39201

CODED

WATER WELL DRILLERS LOG

7/23 1973 Sweet Drilling Madison
 date well completed firm name county well located

LANDOWNER:
Sunny Beachillon
Jackson, Miss
 (mailing address)

WELL LOCATION:
 sec 12 T 7 N R 1 E
2 miles W of Madison
 (distance) (direction) (nearest town)

WELL PURPOSE:
 (home, irrigation, municipal, industrial)

- WELL COMPLETION DATA:
- (1) diameter (inches) 2
 - (2) total depth (feet) 747
 - (3) static water level (feet) 207 below above top of ground.
 - (4) casing Galv. 747
 (material) (depth)
 (size) if telescope see back.
 - (5) screen 15' x 6" 6
 (length) (depth to top)
2 5/8
 (size) (material)
 - (6) pump 5 hp 20
 (HP) (yield gpm)
230V
 (type power)
 - (7) electric log No
 (yes or no)
No
 (organization running log)
 - (8) how well bottom plugged 2" B.W.
Valve

description of fomations encountered	from	to
<u>Brown Clay</u>	<u>0</u>	<u>26</u>
<u>Blue Clay</u>	<u>26</u>	<u>245</u>
<u>Shale</u>	<u>245</u>	<u>400</u>
<u>Shale & rock</u>	<u>400</u>	<u>410</u>
<u>Dark shale</u>	<u>410</u>	<u>430</u>
<u>Clay & sandy shale</u>	<u>430</u>	<u>471</u>
<u>Dark shale</u>	<u>471</u>	<u>619</u>
<u>Dark Clay + Str. Fine Sand</u>	<u>619</u>	<u>640</u>
<u>Gravel Sand</u>	<u>640</u>	<u>745</u>


CODED

DRILLERS REMARKS:

AUG 23 1973

If well telescopes please sketch and show depths.

GROUND LEVEL

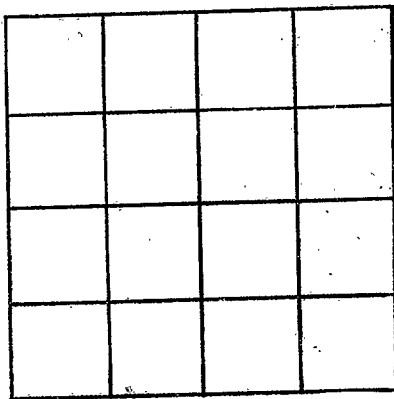

SECTION _____

Please indicate well location X.

ADDITIONAL INFORMATION

If more than one screen, show locations of each on sketch.