

Madison
V7
8-69

MISSISSIPPI
BOARD OF WATER COMMISSIONERS
416 North State Street
Jackson, Mississippi 39201

CODED

WATER WELL DRILLERS LOG

8-18 1969 Layne-Central Co. Madison
date well completed firm name county well located

LANDOWNER:
Tougaloo College,
Tougaloo, Miss
(mailing address)

description of formations encountered	from	to
<u>yellow clay</u>	<u>0</u>	<u>78</u>
<u>loess clay</u>	<u>78</u>	<u>301</u>
<u>shale, soft str. of lime</u>	<u>301</u>	<u>320</u>
<u>Gummy clay</u>	<u>320</u>	<u>338</u>
<u>Brittle shale</u>	<u>338</u>	<u>402</u>
<u>Sandy shale & lignite</u>	<u>402</u>	<u>459</u>
<u>Hard shale</u>	<u>459</u>	<u>478</u>
<u>Rock</u>	<u>478</u>	<u>479</u>
<u>Hard clay</u>	<u>479</u>	<u>516</u>
<u>Sandy shale</u>	<u>516</u>	<u>591</u>
<u>Hard shale</u>	<u>591</u>	<u>609</u>
<u>Fine sand</u>	<u>609</u>	<u>625</u>
<u>Hard shale</u>	<u>625</u>	<u>734</u>
<u>Rock</u>	<u>734</u>	<u>737</u>
<u>Sandy shale</u>	<u>737</u>	<u>758</u>
<u>Sand</u>	<u>758</u>	<u>901</u>

WELL LOCATION:
sec. 35 T 7 N R 1 E
miles _____ of _____
(distance) (direction) (nearest town)

WELL PURPOSE: Domestic
(home, irrigation, municipal, industrial)

WELL COMPLETION DATA:
(1) diameter (inches) 12"
(2) total depth (feet) 842'
(3) static water level (feet) 227 below above top of ground.
(4) casing Steel, 780',
(material) (depth)
12" And 60' of 6"
(size) if telescope see back.
(5) screen 50', 786'
(length) (depth to top)
6" Stainless Steel
(size) (material)
(6) pump 50 (HP) (yield gpm)
Electric
(type power)
(7) electric log yes
(yes or no)
Miss. Geo. Survey
(organization running log)
(8) how well bottom plugged slugs


DRILLERS REMARKS:
No test run as of this date.

SEP - 4 1969
MISS. BD. OF
WATER COMMISSIONERS

(X)

If well telescopes please sketch and show depths.

GROUND LEVEL

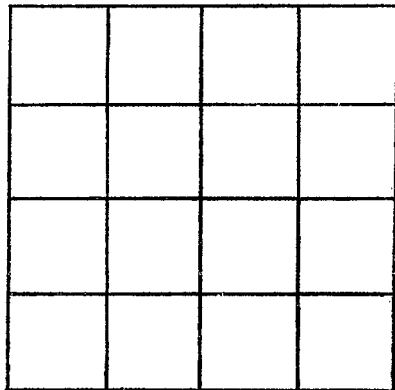

SECTION _____

Please indicate well location X.

ADDITIONAL INFORMATION

If more than one screen, show locations of each on sketch.