

LLW Robinson

MADISON  
V8  
3-68 Elog # 172  
Miss. Geo. Sur  
3-28-68  
date well completed

MISSISSIPPI  
BOARD OF WATER COMMISSIONERS  
416 North State Street  
Jackson, Mississippi 39201

CODED

WATER WELL DRILLERS LOG


19 McNeese Drilling Co Madison  
firm name county well located

LANDOWNER: L.R. Spence  
JACKSON MISS  
(mailing address)  
WELL LOCATION:  
sec 17 T 7 N R 1 E  
7 miles North of Jackson  
(distance) (direction) (nearest town)

description of formations encountered	from	to
SURFACE SOIL	0	10
Grey shale	10	469
Grey sdy sh	469	496
SAND	496	512
Grey sdy sh	512	532
SAND sh STRS	532	612
Grey sh sd STRS	612	708
Grey sh	708	791
SAND	791	811
shale	811	995
Rock	995	998
shale	998	1016
bdy sh	1016	1077
shale	1077	1168
Grey sdy sh	1168	1216
SAND	1216	1231
Grey sh sd STRS	1231	1293
SAND sh STRS	1293	1360
SAND	1360	1436

WELL PURPOSE: HOME  
(home, irrigation, municipal, industrial)

WELL COMPLETION DATA:  
(1) diameter (inches) 4 X 2  
(2) total depth (feet) 1436  
(3) static water level (feet) 172 below top of ground.  
(4) casing steel 1360 (material) (depth)  
4 X 2 (size) if telescope see back.  
(5) screen 20 1360 (length) (depth to top)  
2" .007" .010 stainless steel (size) (material)  
(6) pump 1 10 (HP) (yield gpm)  
Elec (type power)  
(7) electric log yes (yes or no)  
M.G.S. (organization running log)  
(8) how well bottom plugged mud

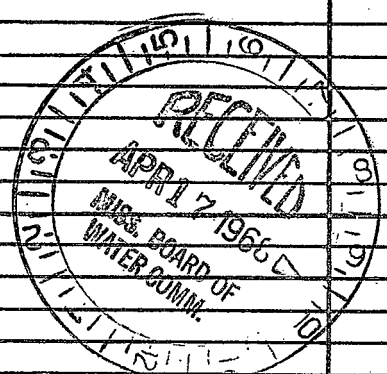

DRILLERS REMARKS:  
Water Does Not have color  
40 G.P.M. 125 COMPRESSOR

If well telescopes please sketch and show depths.

GROUND LEVEL

359' 4" PIPE  
4" x 2" SWIDGE


1001' 2" PIPE

1360' TOP SCREEN

1380' BOTTOM SCREEN

1380' - 1390' BLANK PIPE  
WITH  
BACKWASH  
VALVE ON  
BOTTOM

If more than one screen,  
show locations of each on sketch.

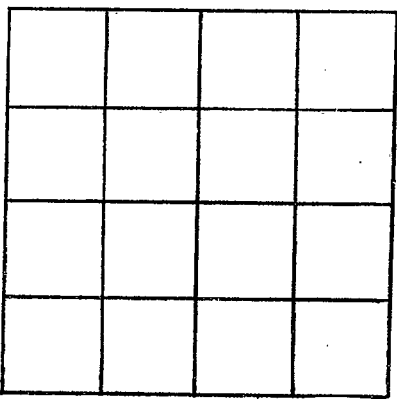

SECTION 17

Please indicate well location X.

ADDITIONAL INFORMATION

A series of horizontal lines for recording additional information.