

MADISON

MISSISSIPPI BOARD OF WATER COMMISSIONERS

V23

6-23-65

WATER WELL DRILLERS LOG

ELOG

#126

CODED

Madison

Date: 6-23-, 1965, Driller: Layne-Central Co. County: Madison

(Name)

- (1) Owner of Land: Richmond Grove Community Water Assn., (Incorp.)
Jackson, Mississippi
(Address)
- (2) Location: NE 1/4, NE 1/4, Sec. 36 T7 R1E,
_____ miles _____ of _____
(distance) (direction) (Nearest Town)
- (3) Topography: _____
(Hilly) (Flat) (Level)
- (4) Purpose of Well: municipal
(Domestic Irrigation
Municipal, Industrial, Other)

Description & Color of Materials Sand, Clay, Red Clay, Shell, etc.	Thick- ness Feet	Depth Feet
Hill clay	28	28
Yazoo clay (blue)	317	345
sandy clay	26	371
clay-sandy clay stks	46	417
sandy clay	35	452
clay	58	510
sandy shale	22	532
sand	53	585
sandy shale	35	620
clay-shale	18	638
shale-sandy	30	668
shale	22	690
clay	45	735
hard shale	71	806
rock	2	808
shale	6	814
rock	2	816
hard shale	14	830
sandy shale	22	852

Information upon completion of well:


- (1) Diameter 8 inches.
- (2) Total Depth 574 feet.
- (3) Water Level 150 feet below top of ground.
- (4) Cased to 405', Size 8"
- (5) Screen: Size 6", Length 41' 9"
- (6) Were any formations sealed against pollution?

x yes, _____ no.

If YES depth of formation 405'

Why _____ required

Drillers Remarks:

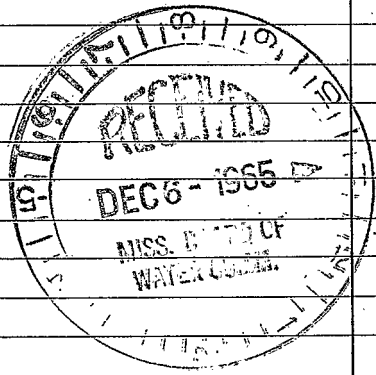

(Use Back Side)

Well No.

