

ELOG # 164


MISSISSIPPI
BOARD OF WATER COMMISSIONERS
416 North State Street
Jackson, Mississippi 39201

WATER WELL DRILLERS LOG

Madison
V26
9-67
Elec Log

date well completed 9-11-67 firm name Gordon-McNees county well located Madison

LANDOWNER:	description of formations encountered	from	to
<u>John Gordon</u> <u>4202 OAKMOUNT DRIVE</u> <u>JACKSON MISS</u> (mailing address)	<u>clay</u> <u>Blue shale</u> <u>Grey sd sh</u> <u>SEND sh strk</u>	<u>0</u> <u>35</u> <u>438</u> <u>558</u>	<u>35</u> <u>438</u> <u>558</u> <u>600</u>
WELL LOCATION: sec. <u>26</u> T <u>7</u> N R <u>1</u> E <u>2</u> miles <u>west</u> of <u>Rolland</u> (distance) (direction) (nearest town)	<u>Grey sh</u> <u>SEND sh strk</u> <u>SEND</u> <u>Grey sh</u> <u>Grey sd sh</u> <u>Grey sh sd strk</u> <u>Rock</u> <u>SEND sh strk</u> <u>SEND</u> <u>Grey sd sh</u> <u>SEND</u> <u>Grey sd sh</u>	<u>600</u> <u>670</u> <u>723</u> <u>743</u> <u>765</u> <u>783</u> <u>804</u> <u>826</u> <u>927</u> <u>997</u> <u>1003</u> <u>1003</u> <u>1008</u> <u>1068</u>	<u>670</u> <u>723</u> <u>743</u> <u>765</u> <u>783</u> <u>804</u> <u>926</u> <u>927</u> <u>997</u> <u>1003</u> <u>1008</u> <u>1068</u> <u>1078</u>
WELL PURPOSE: (home, irrigation, municipal, industrial)			
WELL COMPLETION DATA:			
(1) diameter (inches) <u>4 X 2 1/2</u>			
(2) total depth (feet) <u>1078</u>			
(3) static water level (feet) <u>244</u> below top of ground.			
(4) casing <u>Steel</u> , <u>1032</u> (material) (depth) <u>4" x 2 1/2"</u> if telescope see back. (size)			
(5) screen <u>30'</u> , <u>1032</u> (length) (depth to top) <u>2 1/2</u> , <u>stainless steel</u> (size) (material)			
(6) pump <u>2</u> , <u>156 GPM</u> (HP) (yield gpm) <u>Elec</u> (type power)			
(7) electric log <u>yes</u> (yes or no) <u>M.G.S.</u> (organization running log)			
(8) how well bottom plugged <u>mud</u>			
DRILLERS REMARKS: <u>Water Clear</u>			

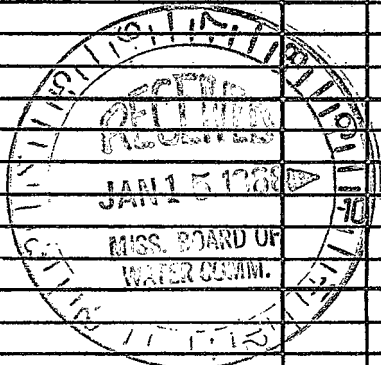

If well telescopes please sketch and show depths.

GROUND LEVEL

4"
 4x2.542d6c $\frac{378}{1}$
 339

2 1/2" $\frac{693}{1032}$

30' 2 1/2"
 STAINLESS
 STEEL
 SCREEN $\frac{30}{1062}$

2 1/2"
 PIPE $\frac{6}{1068}$

X			

SECTION 26

Please indicate well location X.

ADDITIONAL INFORMATION

If more than one screen,
 show locations of each on sketch.