

Madison
V27
10-5-68
M.G.S.

MISSISSIPPI
BOARD OF WATER COMMISSIONERS
416 North State Street
Jackson, Mississippi 39201

CODED

WATER WELL DRILLERS LOG

10-5 date well completed 1968 Layne-Central Co. firm name Madison county well located

LANDOWNER: Swington Road

description of formations encountered	from	to
<u>Sandy Clay</u>	<u>0</u>	<u>10</u>
<u>Red Clay</u>	<u>10</u>	<u>42</u>
<u>Upper Clay</u>	<u>42</u>	<u>42.5</u>
<u>Shale</u>	<u>42.5</u>	<u>50.5</u>
<u>Fine sand, Sths. of shale</u>	<u>50.5</u>	<u>53.2</u>
<u>Shale</u>	<u>53.2</u>	<u>560</u>
<u>Fine sand + Shale</u>	<u>560</u>	<u>584</u>
<u>Shale</u>	<u>584</u>	<u>59.5</u>
<u>Hard Shale, Sths. of sand</u>	<u>59.5</u>	<u>63.8</u>
<u>Sand</u>	<u>63.8</u>	<u>65.7</u>
<u>Sand Sths. of Shale</u>	<u>65.7</u>	<u>67.9</u>
<u>Sand</u>	<u>67.9</u>	<u>70.1</u>
<u>Shale</u>	<u>70.1</u>	<u>706</u>

Water Association
(mailing address)

WELL LOCATION:
sec. 28 T. 7 N R. 1 E
4 miles West of Ridgeland
(distance) (direction) (nearest town)

WELL PURPOSE: Domestic
(home, irrigation, municipal, industrial)

WELL COMPLETION DATA:

- (1) diameter (inches) 6"
- (2) total depth (feet) 706'
- (3) static water level (feet) 260' below top of ground.
- (4) casing Steel, 616'
(material) (depth)
6" x 64' B 4"
(size) if telescope see back.
- (5) screen 40', 656'
(length) (depth to top)
4" Stainless Steel
(size) (material)
- (6) pump 15 60
(HP) (yield gpm)
Electric
(type power)
- (7) electric log yes
(yes or no)
Miss Gen Survey
(organization running log)
- (8) how well bottom plugged Valve

DRILLERS REMARKS:

CODED
APR 15 1968


MISS. BD. OF
WATER COMMISSIONERS
APR 15 1968

MISS. BD. OF
WATER COMMISSIONERS
APR 15 1968
MISS. BD. OF
WATER COMMISSIONERS

⊗

If well telescopes please sketch and show depths.

GROUND LEVEL

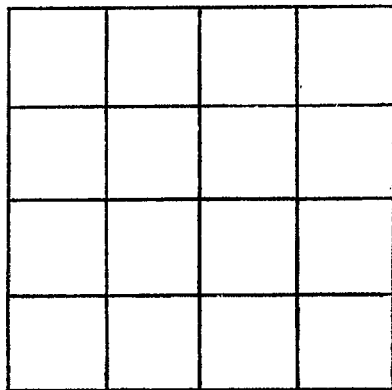

SECTION 28

Please indicate well location X.

ADDITIONAL INFORMATION

If more than one screen, show locations of each on sketch.