

Madison
 V 27
 10-5-68
 M.G.S.

MISSISSIPPI
 BOARD OF WATER COMMISSIONERS
 416 North State Street
 Jackson, Mississippi 39201

CODED
 CODED
WATER WELL DRILLERS LOG

10-5 1968 Layne Central Co. Madison
 date well completed firm name county well located

LANDOWNER: Livingston Road
Water Association

description of formations encountered	from	to
<u>Sandy Clay</u>	0	10
<u>Pipe Clay</u>	10	42
<u>Clay</u>	42	42.5
<u>Shale</u>	42.5	505
<u>Fireland, streaky shale</u>	505	532
<u>Shale</u>	532	560
<u>Fine Sand and Shale</u>	560	584
<u>Shale</u>	584	595
<u>Hard Shale, streaks of sand</u>	595	638
<u>Sand</u>	638	657
<u>Sand, streaks of shale</u>	657	679
<u>Sand</u>	679	701
<u>Shale</u>	701	706

(mailing address)

WELL LOCATION:
 sec 28 T 7 N R 1 E
4 miles West of Ridgeland
 (distance) (direction) (nearest town)


WELL PURPOSE: Domestic
 (home, irrigation, municipal, industrial)

WELL COMPLETION DATA:

- (1) diameter (inches) 6"
- (2) total depth (feet) 706'
- (3) static water level (feet) 260' below above top of ground.
- (4) casing Steel, 6 1/2",
 (material) (depth)
6" If telescope see back.
 (size)
- (5) screen 40', 637'
 (length) (depth to top)
4", Stainless Steel
 (size) (material)
- (6) pump _____ (HP) _____ (yield gpm)
Electric
 (type power)
- (7) electric log Yes
 (yes or no)
Miss. Geo. Survey
 (organization running log)
- (8) how well bottom plugged valve and
slugs


DRILLERS REMARKS:

Pump not installed
as of this date

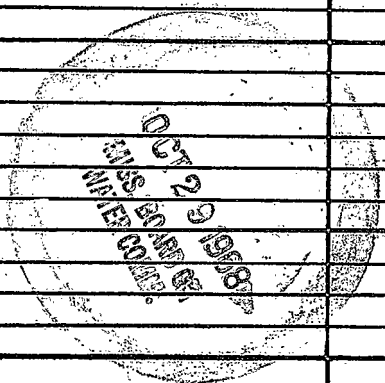

If well telescopes please sketch and show depths.

GROUND LEVEL

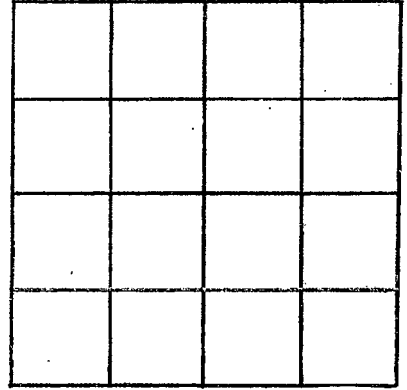

SECTION 28

Please indicate well location X.

ADDITIONAL INFORMATION

If more than one screen, show locations of each on sketch.