

Madison  
 V28  
 6-21-69  
 M.G.S.  
 6-21-69

MISSISSIPPI  
 BOARD OF WATER COMMISSIONERS  
 416 North State Street  
 Jackson, Mississippi 39201

CODED

WATER WELL DRILLERS LOG

19 James McNeese Madison  
 date well completed firm name county well located

LANDOWNER: C.A. Sullivan  
 Livingston Road  
 Jackson Miss  
 (mailing address)

WELL LOCATION:  
 sec. 20 T 7 N R 1 E  
 6 miles West of Ridgeland  
 (distance) (direction) (nearest town)

WELL PURPOSE:  
 (home, irrigation, municipal, industrial)

WELL COMPLETION DATA:  
 (1) diameter (inches) 4" x 2 1/2"  
 (2) total depth (feet) 1450  
 (3) static water level (feet) 224 below top of ground.  
 (4) casing steel 13/8 (material) (depth)  
 (size) if telescope see back.  
 (5) screen 31 13/8 (length) (depth to top)  
 2 1/2" 008 stainless steel (size) (material)  
 (6) pump 1 1/2 16 (HP) (yield gpm)  
 Elec (type power)  
 (7) electric log yes (yes or no)  
 M.G.S. (organization running log)  
 (8) how well bottom plugged mud


description of formations encountered	from	to
surface soil	0	15
Blue shale	15	520
Grey Green sdy sh	520	540
Grey sh - sandy	540	570
Grey sh	570	580
Grey sh sd strk	580	630
Grey sh	630	716
SAND FINE ?	716	746
Grey sh	746	754
SAND	754	757
Grey sh sd strk	757	807
Rock	807	808
Hard Shale	808	833
SAND	833	839
Hard Grey sdy sh	839	878
Brown sh	878	939
Rock	939	943
Brown sh	943	1033
Rock	1033	1034
Brown sh	1034	1274
Grey sdy sh	1274	1294
SAND	1294	1350
Sdy sh	1350	1365
Rock	1365	1368
Grey sdy sh	1368	1384
SAND	1384	1450
19 JTS 4"	405	
1-4" x 2 1/2" swadge	1	
43 JTS 2 1/2"	406	
1"	912	
2 1/2" MOD JOHNSON, STAINLESS STEEL	1378	
SCREW	31	
	1349	

DRILLERS REMARKS:  
 Water does NOT  
 have color

JUN 27 1969

If well telescopes please sketch and show depths.

GROUND LEVEL

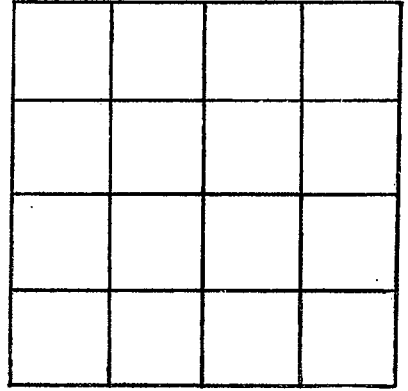

SECTION 20

Please indicate well location X.

ADDITIONAL INFORMATION

If more than one screen, show locations of each on sketch.