

MADISON WATER WELL DRILLERS LOG

3902
MADISON
CO. MISS.

Date: 9/18 ^{V31} 9/18/63, 1963, Driller: Frank Mayo, Sr. County: Madison
(Name)


(1) Owner of Land: George Coleman
(Name)
Rt 3 Jackson, Miss
(Address)
(2) Location: 2 1/4 1/4, 1/4, Sec. 21 T. 7N R. 1E
(distance) (direction) (Nearest Town)
(3) Topography: Level
(Hilly) (Flat) (Level)
(4) Purpose of Well: Home
(Domestic Irrigation Municipal, Industrial, Other)

Description & Color of Materials Sand, Clay, Red Clay, Shell, etc.	Thick- ness Feet	Depth Feet
<u>Brn silt + Chalk</u>	<u>0</u>	<u>26</u>
<u>Blue clay</u>		<u>212</u>
<u>Blue clay + Shale</u>		<u>225</u>
<u>Blue clay</u>		<u>286</u>
<u>Shale</u>		<u>450</u>
<u>Hard shale</u>		<u>520</u>
<u>Shale + Sh. Rock</u>		<u>533</u>
<u>Loam, shell, + shale</u>		<u>588</u>
<u>Fine sand</u>		<u>598</u>
<u>Soft clay</u>		<u>617</u>
<u>Shale + Sh. Shale</u>		<u>627</u>
<u>Shale</u>		<u>638</u>
<u>Fine sand</u>		<u>648</u>
<u>Shale</u>		<u>742</u>
<u>Shale + Sh. sand</u>		<u>760</u>
<u>Fine sand + Sh. shale</u>		<u>775</u>
<u>Fine sand</u>		<u>808</u>

Information upon completion of well:

(1) Diameter 2 inches.
(2) Total Depth 808 feet.
(3) Water Level 252 feet below top of ground.
(4) Cased to 798, Size 2"
(5) Screen: Size 2", Length 10ft.
(6) Were any formations sealed against pollution?
_____ yes, X no.

CODED

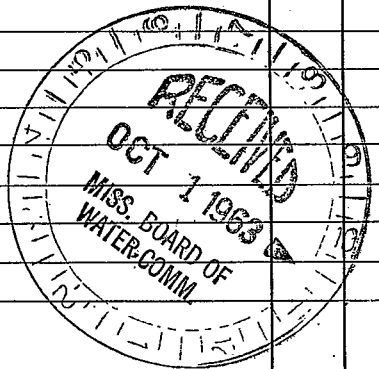

If YES depth of formation _____
Why _____
Drillers Remarks: _____

(Use Back Side)

Well No.

1870

1871

1872

1873

1874

1875

1876

1877

1878

1879

1880