

MADISON

V 32

8-24-61

WATER WELL DRILLERS LOG

CODED

Date: Aug 24, 1961, Driller: M. G. Kay

County: MADISON

(Name)

(1) Owner of Land: Geo. Klaas
(Name)
Jackson
(Address)

(2) Location: 1/4, 1/4, Sec. 31, T. 7 N. E.
5 miles N.W. of Jackson
(distance) (direction) (Nearest Town)

(3) Topography: (Hilly) (Flat) (Level)

(4) Purpose of Well: Home
(Domestic Irrigation
Municipal, Industrial, Other)

Description & Color of Materials Sand, Clay, Red Clay, Shell, etc.	Thick- ness Feet	Depth Feet
White Clay	0	20
Blue Clay	21	41
Blue Clay	42	83
Yellow Clay	231	314
Yellow Clay	252	566
Red Shells & Gravel	399	965
" " " "	420	1385
Sandy Clay	441	1826
" " " "	462	2288
" " " "	504	2792
Rock & Clay	588	3380
Fine Sand	609	3989
" Sand	630	4619
Blue Clay	735	5354
Rock	793	6147
Clay	797	6944
Rock & Clay	798	7742
Rock - Sand	861	8603
Fine Sand	882	9485
Rock - Sand	903	10388
Sand Finer	924	11312
Fine Sand	945	12257
Fine Sand	956	13213
Set Screen 1050 ft		
Real Fine Sand	1050	14263

Information upon completion of well:

(1) Diameter 2 inches.

(2) Total Depth 1050 feet.

(3) Water Level 140 feet below top of ground.

(4) Cased to _____, Size _____.


(5) Screen: Size 006, Length 40.

(6) Were any formations sealed against pollution?
_____ yes, no.

If YES depth of formation

Why

Drillers Remarks:

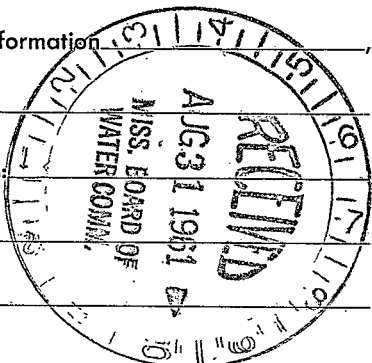

3 HP air pump
3/4 air line

(Use Back Side)

Well No.

